IREDELL COUNTY HEALTH DEPARTMENT

STATESVILLE 704-878-5305 MOORESVILLE 704-664-5281

IMPROVEMENT PERMIT / AUTHORIZATION TO CONSTRUCT / OPERATION PERMIT / EXISTING SYSTEM INSPECTION

PERMIT# 102999 PIN# 4706-54-0553 DATE 10/26/01

OWNER OR CONTRACTOR Diane Stewart PHONE: Business (704)657-4874 Home

ADDRESS 147 Robertson Road Statesville, N.C. 28625

LOCATION Hwy 90 W, (L) Robertson Rd, bear to right House Green on Right # 147 Robertson

SUBDIVISION BLOCK / SECTION — LOT — LOT AREA Acres SITE CLASS F5 DESIGN FLOW 360 L.T.A.R. .3

Septic Tank: Existing 1000 Gallons; STB — Date —
Pump Tank: Gallons; PT Date
Pump Make: Model Serial No.
Nitrification Field: No Fields 1 Square Feet 540 Linear Feet 180
No Lines 2@90 Trench Width 36" Max Trench Bottom Depth 30" Gravel Depth 12"

~~X~~ New System ☐ Repair System Type: I (II) III. IV. V. VI
System Description: Gravity, Conventional
Repair System Description:
Maintenance Agreement Required: ☐ Yes X No

X House/Mod. Home No. Bedrooms 3
☐ Mobile Home No. Bathrooms 2
☐ Business No. Employees
☐ Other


☐ Slab X Crawl Space ☐ Basement w/plumbing ☐ Basement wo/plumbing

Water Supply: ☐ Individual X Public ☐ Community


Comments:/Conditions: (1) Add New Toe if needed (2) Add or replace Existing Distribution Box, (3) Install 2 Lines 90ft. (4) Abort Install when wet.

Comments:/Conditions: Old Ex. Wash Tank pumped & crushed - replaced w/New Septic Tank 1,000gal - STB-1000 ; date - 1-5-02.

INITIAL SITE SKETCH (Not to Scale)

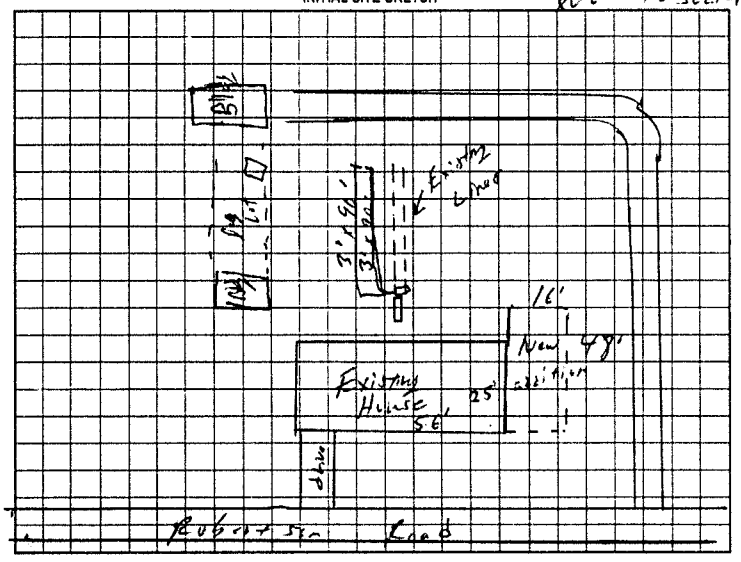

AS BUILT SKETCH

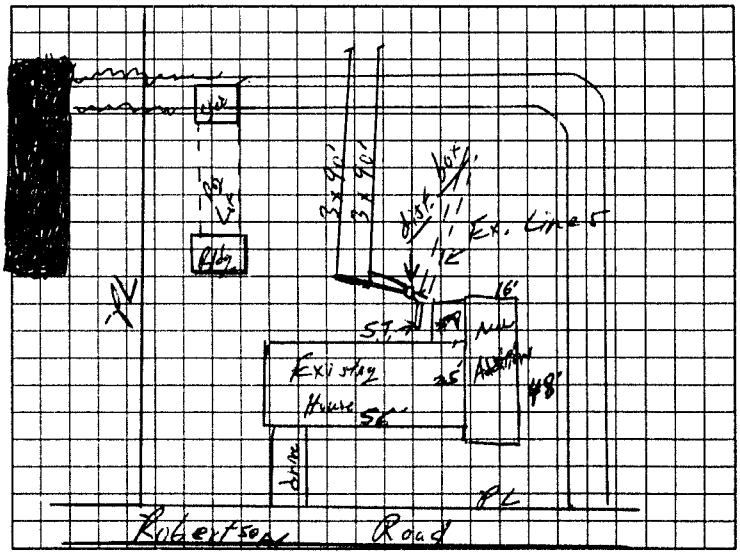

Permit can be suspended or revoked if any false information is supplied toward securing the permit/any unauthorized changes are made to the site/any unauthorized changes are made in the installation of the system. Improvement Permit with plat valid without expiration. Improvement Permit with site plan valid for sixty months. Authorization to Construct is valid for a period equal to that of Improvement Permit – not to exceed sixty months.

Signed: Josh A McMillan date

Improvement Permit by: William O. Johnson date 10/26/01

Authorization to Construct by: William O. Johnson date 10/26/01

Installed by: Kelly Ward

Operation Permit by: William O. Johnson date 2/14/02

Existing System Inspection by: date

HEALTH DEPT COPY: WHITE OWNER COPY (FINAL): YELLOW OWNER COPY (INITIAL): PINK