IREDELL COUNTY HEALTH DEPARTMENT

Statesville Phone TR 3-7271 Mooresville Phone NO 3-1271

PERMIT TO INSTALL SEPTIC TANK

Permit NO. _____ Permit Date Jan 2 1961

Owner Mr. Russell Mayhew Address Statesville

Installed By Roy D. Long Address Statesville


Location of Property Just Below Scotts School from Stony Point 1st Bridge on Rt.

Tank		Capacity		Length of Lines		Fixtures	
Block	( )	800	( )	150'	( )	No. of Baths	(1)
Precast	( )	900	( )	175'	( )	Dishwasher	( )
Poured		1000	(✓)	200'	( )	Garbage Grdr.	( )
		1100	( )	225'	(✓)	Auto-Washer	(✓)
		1200	( )	250'	( )	Other	
		Other		Other			

NOTIFY HEALTH DEPARTMENT AT LEAST EIGHT HOURS BEFORE TANK IS TO BE INSPECTED.

Final Inspection Jan 7 1961 Approved (✓) Disapproved ( )

Remarks _____

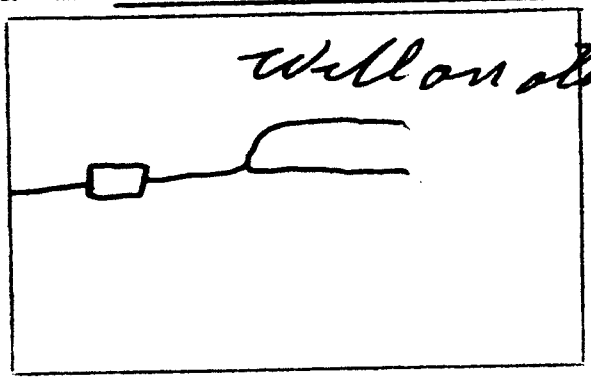

Sketch of Installation

R.T.

Sanitarian