IREDELL COUNTY HEALTH DEPARTMENT

STATESVILLE 704-878-5305 MOORESVILLE 704-664-5281

IMPROVEMENT PERMIT / AUTHORIZATION TO CONSTRUCT / OPERATION PERMIT / EXISTING SYSTEM INSPECTION

PERMIT # 157496 PIN # 4706-56-5645 DATE 23 July 09

OWNER or APPLICANT Nicholas Magallanes PHONE: Business (704) 872-0922 Home:

OWNER or APPLICANT ADDRESS 4618 Taylorsville Hwy Statesville

LOCATION / DIRECTIONS Scotts Creek Rd. TR Logan - New Amity Rd. on left across from New Amity AME Church

SUBDIVISION BLOCK / SECTION LOT # LOT AREA 1.42 ac. DESIGN FLOW 480 g/d. L.T.A.R. 0.3 ac/ac

Septic Tank 1000g Gallons: STB 1007 Date 8-3-09

Pump Tank Gallons: P T Date

Pump Make Model Serial #

Nitrification Field No Fields 1 No Lines 4 Linear Feet 400'

Trench Width 36" Max. Trench Bottom Depth 36" Gravel Depth NA

☑ New System ☐ Repair ☐ Expansion System Type I II III IV V VI

System Description: 25% Reduction - Comp. Pump

Repair System Description: 25% Reduction - Pump

Maintenance Agreement Required ☐ YES ☑ NO

☑ GRAVITY ☐ PRESSURE

☑ Residence No. Bedrooms 4

☐ Business No. Persons

☐ Other No. Employees

☐ Slab ☑ Crawl Space

☐ Basement w/plumbing ☐ Basement w/o plumbing

Water Supply: ☐ Private ☑ Public ☐ Community

Comments / Conditions: Follow contour / Honor all setbacks / Keep 50'± from any wells.

Comments / Conditions

INITIAL SITE SKETCH

Please see Attached Site Sketch

AS BUILT SKETCH

Permit can be suspended or revoked if any false information is supplied toward securing the permit / any unauthorized changes are made to the site / any unauthorized changes are made in the installation of the system.

☐ *IMPROVEMENT PERMIT w / plat valid without expiration.* ☑ *IMPROVEMENT PERMIT w / site plan valid for 60 mos.* ☑ *AUTHORIZATION TO CONSTRUCT valid for period equal to IMPROVEMENT PERMIT-not to exceed 60 mo.*

Owner / Applicant Signature: Date 7/23/09

Improvement Permit by: , R.S. Date 23 July 09

Authorization to Construct by: , R.S. Date 23 July 09

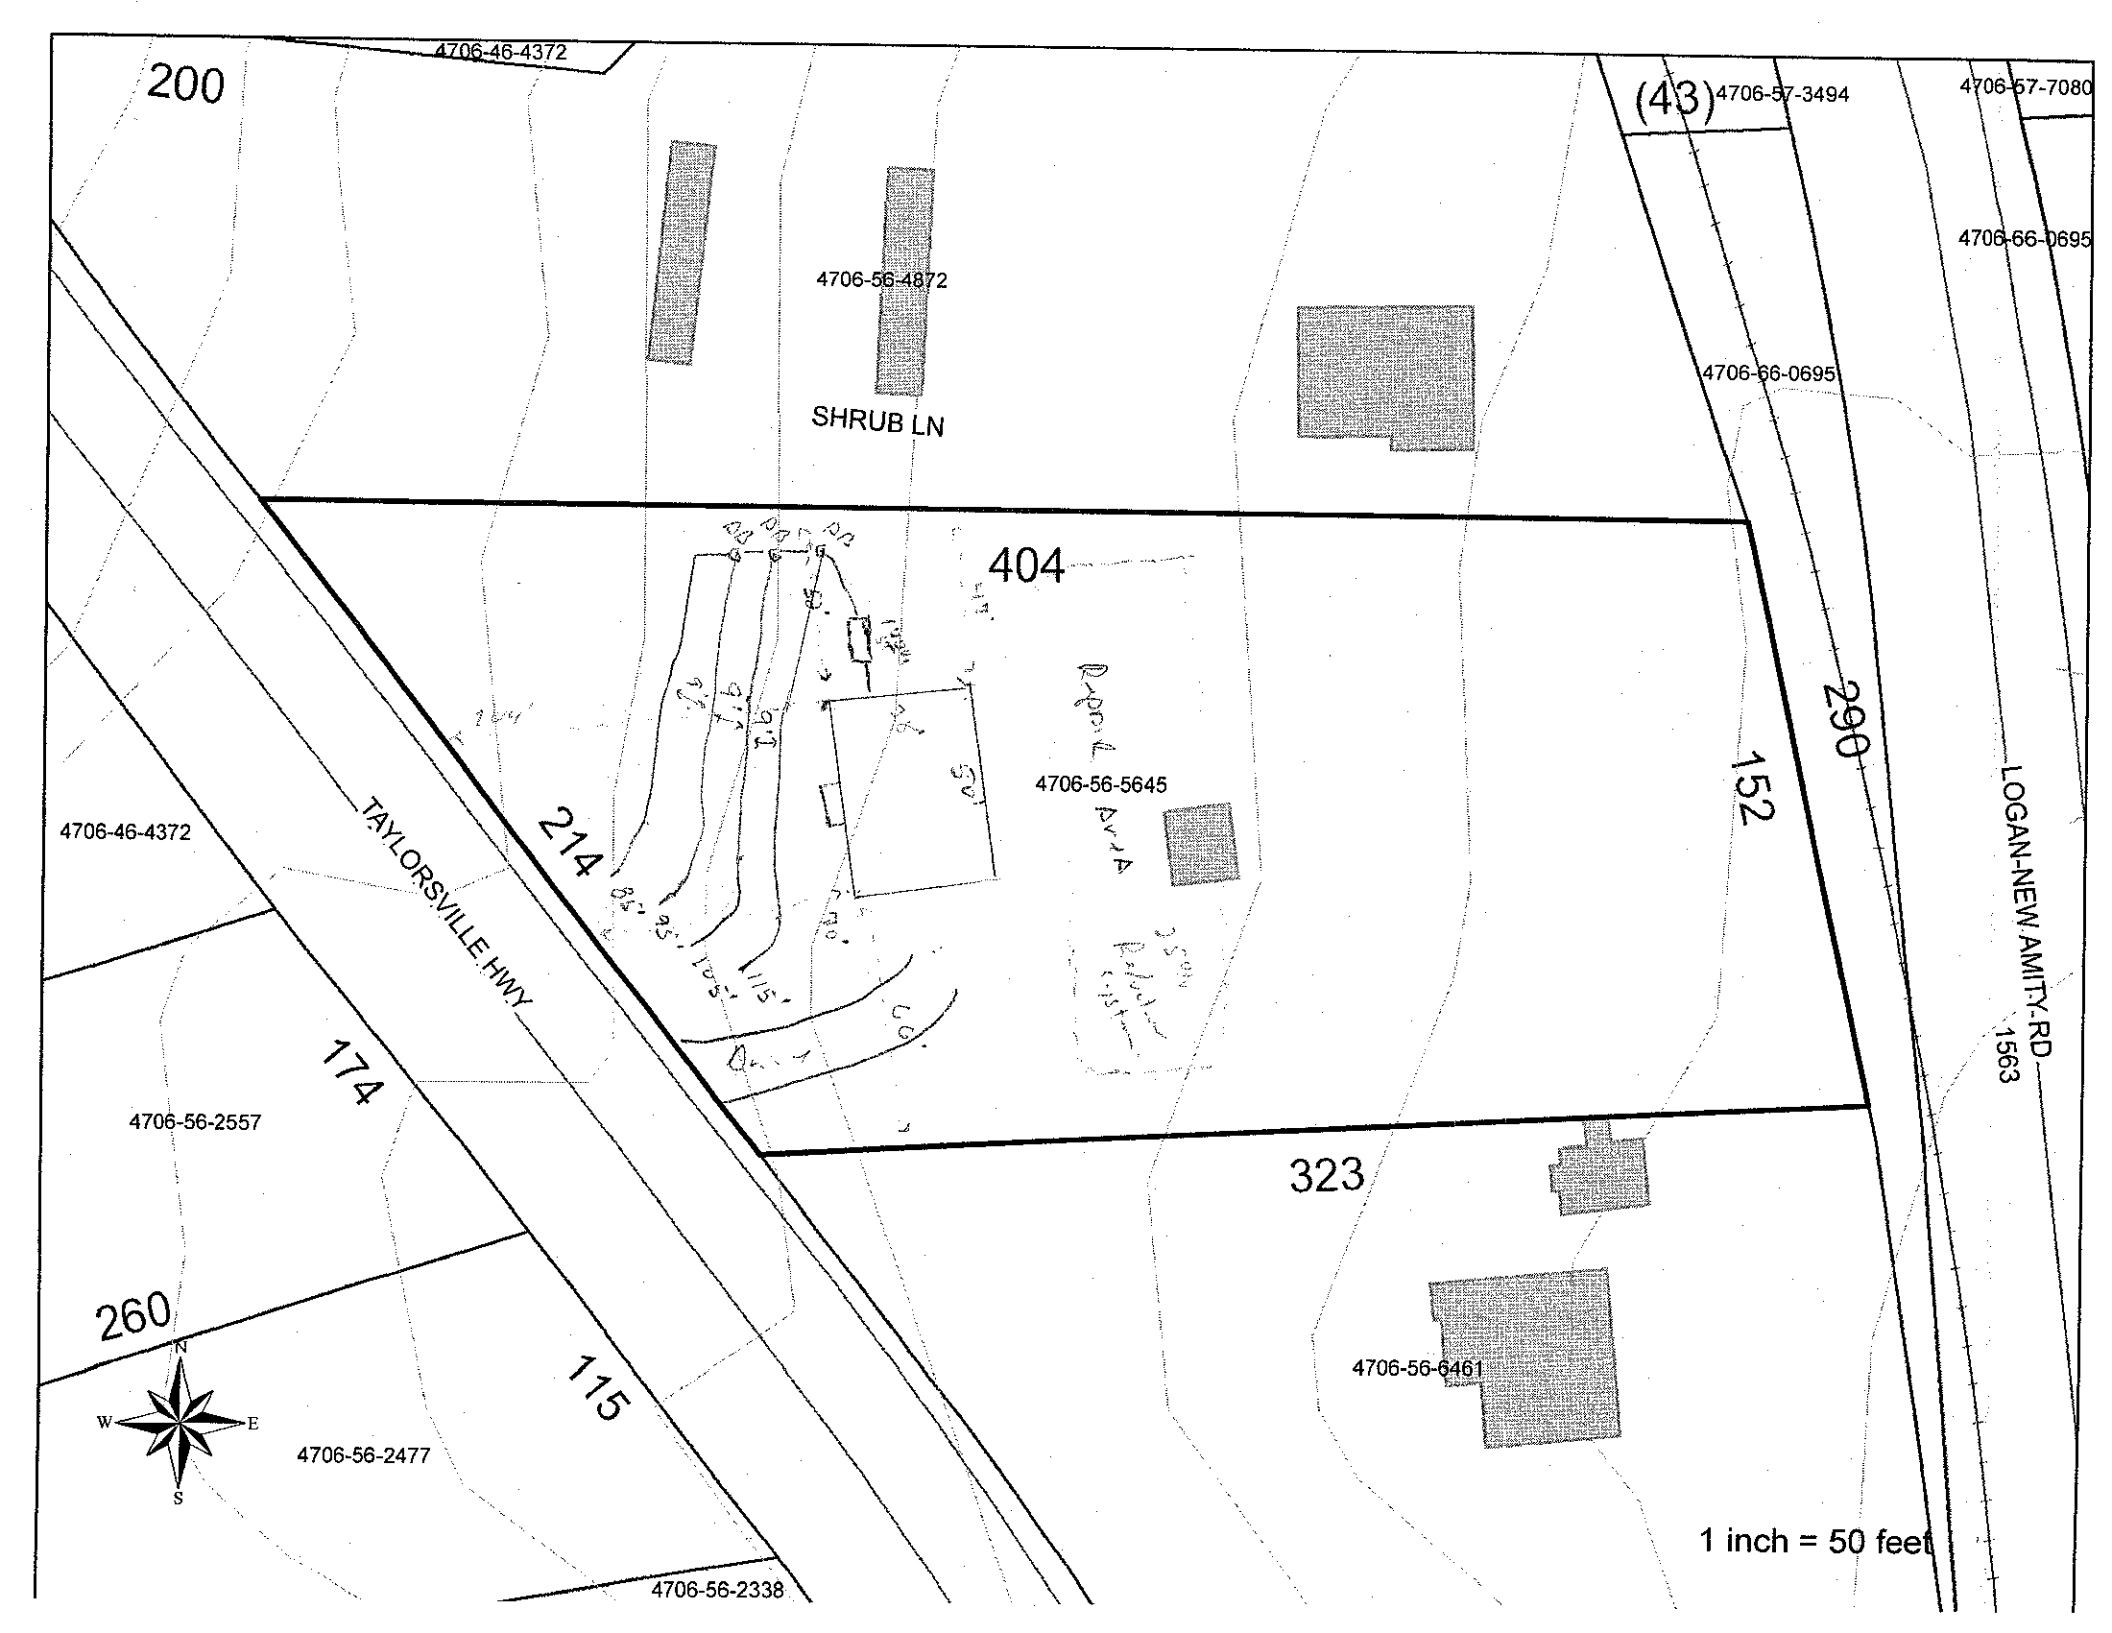
Installed by: Tommy Cothran

Operation Permit by: Date: 9-25-09

Existing System Inspected by: Date:

YOU SHOULD CONTACT A LOCATOR SERVICE PRIOR TO ANY EXCAVATION.

WHITE COPY Environmental Health YELLOW COPY (Final) Owner / Applicant PINK COPY (Initial) Owner / Applicant


200
4706-46-4372
(43)
4706-57-3494
4706-57-7080
4706-66-0695
4706-56-4872
SHRUB LN
4706-66-0695
404
290
152
LOGAN-NEW AMITY-RD
1563
4706-56-5645
214
TAYLORSVILLE HWY
4706-46-4372
174
4706-56-2557
323
260
115
4706-56-2477
4706-56-6461
4706-56-2338
N
W
E
S
1 inch = 50 feet