IREDELL COUNTY HEALTH DEPARTMENT

STATESVILLE 704-878-5305 MOORESVILLE 704-664-5281

IMPROVEMENT PERMIT / AUTHORIZATION TO CONSTRUCT / OPERATION PERMIT / EXISTING SYSTEM INSPECTION

PERMIT# 083365 PIN# 4706672037 (pt.) DATE Nov. 12, '99

OWNER OR CONTRACTOR Crandall & O'Brian Const. PHONE: Business 871-1536 Home

ADDRESS 310 Treebark Rd. Statesville

LOCATION 90 West TR Scotts Creek Rd. XRR immediately TL New Amity Rd 1st lot on Right TR Westscott Dr. 5 corner Lot

SUBDIVISION Westscott BLOCK / SECTION LOT 23 LOT AREA .588 ac SITE CLASS PS DESIGN FLOW 360 gpd L.T.A.R. .3

Septic Tank: 1000 Gallons; STB 10/2 Date 9-1-01

Pump Tank: Gallons; PT Date

Pump Make: Model Serial No.

Nitrification Field: No Fields 1 Square Feet 1200 Linear Feet 400

No Lines 4 @ 100' Trench Width 36" Max Trench Bottom Depth 36" Gravel Depth 12"

☑ New System ☐ Repair System Type: I, II, III, IV, V, VI

System Description: Gravity Conventional

Repair System Description: Gravy/pumped Innovative

Maintenance Agreement Required: ☐ Yes ☑ No

☐ Slab ☑ Crawl Space ☐ Basement w/plumbing ☐ Basement wo/plumbing

☑ House/Mod. Home No. Bedrooms 3

☐ Mobile Home No. Bathrooms 2

☐ Business No. Employees

☐ Other

Water Supply: ☐ Individual ☑ Public ☐ Community


Comments/Conditions: Remove old burn/terrace!

Comments/Conditions


- Septic Tank Marker Installed
- Poly Lok Filter Installed

1" = 50'

INITIAL SITE SKETCH

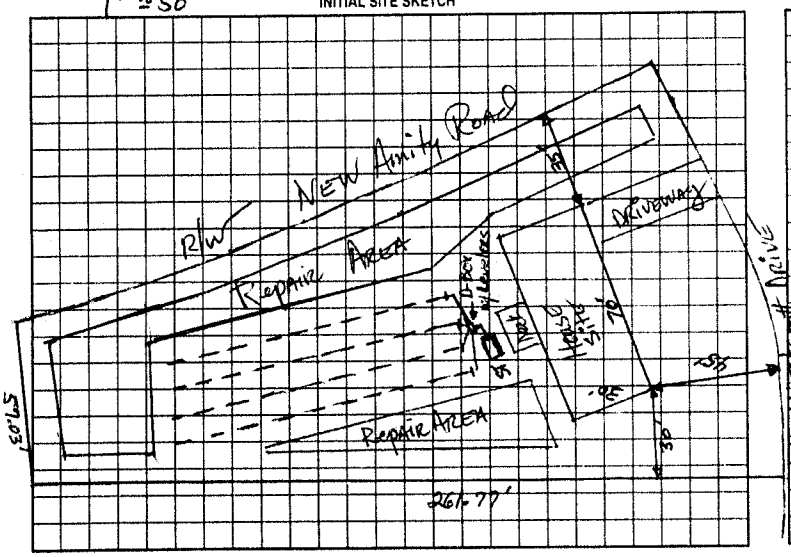

AS BUILT SKETCH

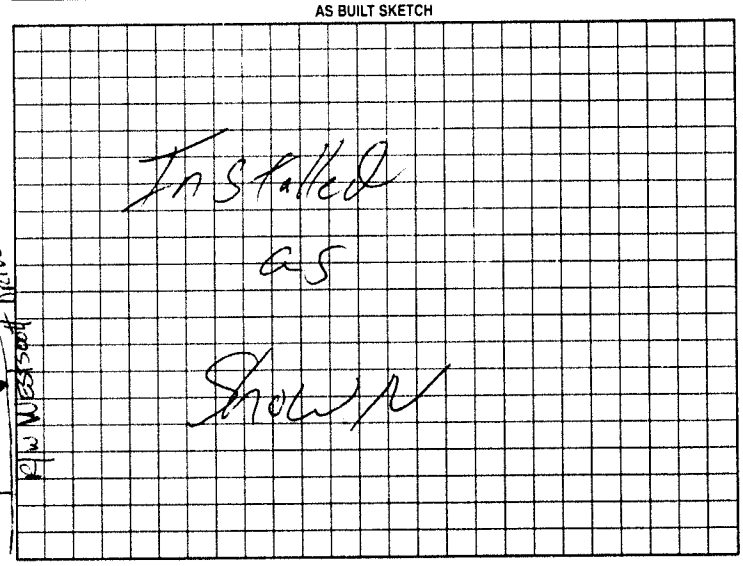

Permit can be suspended or revoked if any false information is supplied toward securing the permit/any unauthorized changes are made to the site/any unauthorized changes are made in the installation of the system. Improvement Permit with plat valid without expiration. Improvement Permit with site plan valid for sixty months. Authorization to Construct is valid for a period equal to that of Improvement Permit – not to exceed sixty months.

Signed: Jammie Henry date 11-15-99

Improvement Permit by: Kevin R. Finan, RS date 11-12-99

Authorization to Construct by: William O. Johnson, REP date 5-04-01

Installed by: A-1 Backhoe

Operation Permit by: William O. Johnson date 11/5/01

Existing System Inspection by: date

HEALTH DEPT. COPY WHITE OWNER COPY (FINAL) YELLOW OWNER COPY (INITIAL) PINK