IREDELL COUNTY HEALTH DEPARTMENT

STATESVILLE 704-878-5305 MOORESVILLE 704-664-5281

IMPROVEMENT PERMIT / AUTHORIZATION TO CONSTRUCT / OPERATION PERMIT / EXISTING SYSTEM INSPECTION

PERMIT# 08334 PIN# 4706672037 (pt) DATE October 25, '99

OWNER OR CONTRACTOR Crandell & O'Brien Const. PHONE: Business 871-1536 Home

ADDRESS 310 Treabuk Rd. Statesville

LOCATION 90 W. TR Scotts Creek Rd. X RR immediately TL New Amity TR Westcott Dr. on left

SUBDIVISION Westcott BLOCK / SECTION LOT 2 LOT AREA .908ac SITE CLASS PS DESIGN FLOW 360gpd L.T.A.R. .3

Septic Tank: 1050 Gallons; STB 1012 Date 3-17-01 ☑ New System ☐ Repair System Type: I. II. III IV. V. VI

Pump Tank: Gallons; PT Date

Pump Make: Model Serial No.

Nitrification Field: No Fields 1 Square Feet 900 Linear Feet 300

No Lines 4 @ 75' Trench Width 36" Max Trench Bottom Depth 36"

System Description: Gravity Innovative -25% Red.

Repair System Description: pumped- Innovative -25% Red.

Maintenance Agreement Required: ☐ Yes ☑ No

Gravel Depth N/A ☐ Slab ☑ Crawl Space ☐ Basement w/plumbing ☐ Basement wo/plumbing

☐ House/Mod. Home No. Bedrooms 3

☐ Mobile Home No. Bathrooms 2

☐ Business No. Employees

☐ Other


Water Supply: ☐ Individual ☐ Public ☐ Community

Comments/Conditions: * ONE inspection port per Lateral. Remove old burn/fence


Comments/Conditions: -50 Infiltrator Chambers Installed
- Septic Tank Marker Installed
- Inspection Pipes installed
- Poly/Ice Filter Installed

INITIAL SITE SKETCH

1" = 50'

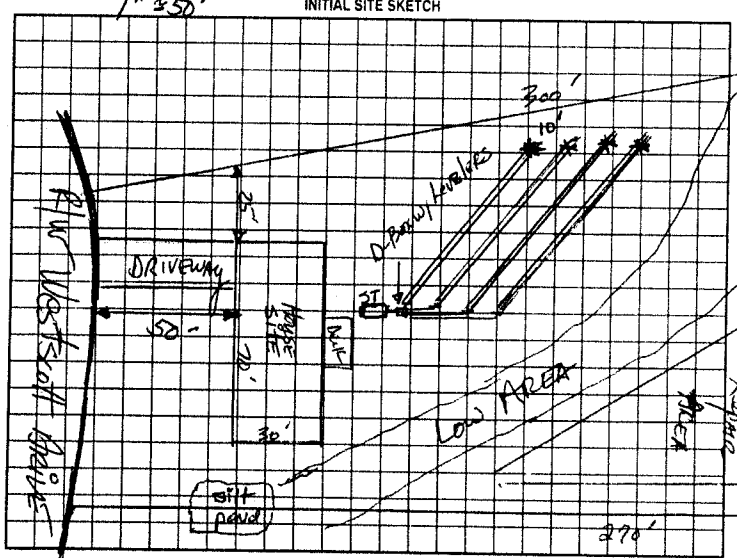

AS BUILT SKETCH

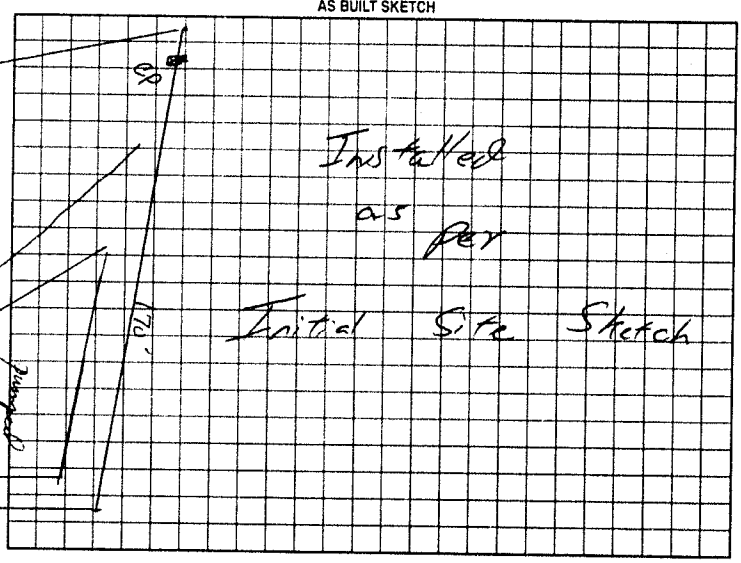

Permit can be suspended or revoked if any false information is supplied toward securing the permit/any unauthorized changes are made to the site/any unauthorized changes are made in the installation of the system. Improvement Permit with plat valid without expiration. Improvement Permit with site plan valid for sixty months. Authorization to Construct is valid for a period equal to that of Improvement Permit – not to exceed sixty months.

Signed: date 11-10-99 Installed by: A-1 Backhoe

Improvement Permit by: date 10-25-99 Operation Permit by: William G. Johnson date 07-24-01

Authorization to Construct by: STEVE HEDRICK date 2-13-01 Existing System Inspection by: date

HEALTH DEPT. COPY WHITE OWNER COPY (FINAL) YELLOW OWNER COPY (INITIAL) PINK