IREDELL COUNTY HEALTH DEPARTMENT

STATESVILLE 704-878-5305 MOORESVILLE 704-664-5281

IMPROVEMENT PERMIT / CERTIFICATE OF COMPLETION / OPERATION PERMIT / EXISTING SYSTEM INSPECTION

PROPERTY DESCRIPTION NO. 067831 DATE 7-10-97 TAX MAP NO. 4706578669 Watershed: ☐ Yes ☑ No

OWNER OR CONTRACTOR JEFFREY BUSTLE PHONE: Business Home 585-9190

ADDRESS P.O. BOX 74, SCOTTS, NC 28699

LOCATION NC 90 W, TR SCOTTS CREEK RD, TR NEW AMITY TR COLFAX, LOT #2 ON LEFT

SUBDIVISION OAK HILL BLOCK / SECTION LOT 2 LOT AREA 1.0 ACRE SITE CLASS. PS DESIGN FLOW 240 L.T.A.R. 0.30 GPD/FT²

Septic Tank: 1000 Gallons; STB 1012 Date 3-14-97

Pump Tank: Gallons; PT Date

Pump Make: Model Serial No.

Nitrification Field: No Fields 1 Square Feet 810 Linear Feet 270

No Lines THREE Trench Width 36" Max Trench Bottom Depth 36" Gravel Depth 12"

☑ New System ☐ Repair System Type: I, (II), III, IV, V, VI

System Description: CONVENTIONAL GRAVITY

Repair System Description: CONV. PUMP/GRAV.

Maintenance Agreement Required: ☐ Yes ☑ No

☐ House/Mod. Home ☑ Mobile Home ☐ Business ☐ Other

No. Bedrooms 2 No. Bathrooms 2 No. Employees


☐ Slab ☑ Crawl Space ☐ Basement w/plumbing ☐ Basement wo/plumbing

Water Supply: ☐ Individual ☐ Community ☑ Public

Comments: INSTALL LINES ON CONTOUR AS FLAGGED

Comments:

INITIAL SITE SKETCH SCALE: 1"=50'

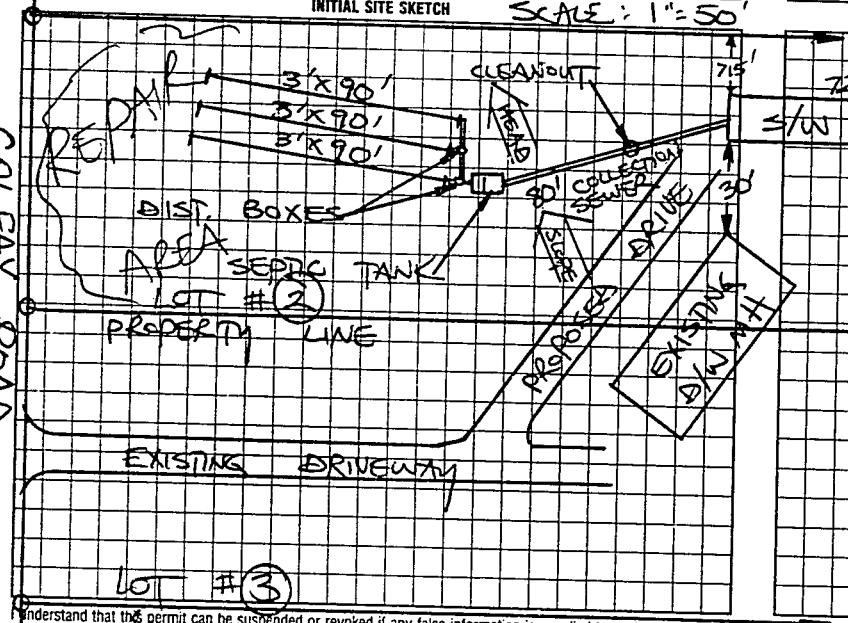

AS BUILT SKETCH

Installed as shown

I understand that this permit can be suspended or revoked if any false information is supplied toward securing the permit/any unauthorized changes are made to the site/any unauthorized changes are made in the installation of the system. Improvement Permit is valid for 60 months from date of issuance. AUTHORIZATION TO CONSTRUCT IS VALID FOR 60 MONTHS FROM DATE OF ISSUANCE.

Signed:

Improvement Permit by: STEVE HEDRICK date 7-10-97

AUTH. TO CONSTRUCT

Existing System Inspection by: STEVE HEDRICK date 7-10-97

Installed by: Eskor Elder

~~Certificate of Completion by:~~ date

Operation Permit by: Mark C. Ortz RS date 7-15-97

HEALTH DEPT. COPY: WHITE INSPECTION COPY (FINAL) GREEN OWNER COPY (FINAL) YELLOW INSPECTION COPY (INITIAL) PINK OWNER COPY (INITIAL) BLUE