# IREDELL COUNTY HEALTH DEPARTMENT

STATESVILLE 704-878-5305 MOORESVILLE 704-664-5281

## IMPROVEMENT PERMIT / AUTHORIZATION TO CONSTRUCT / OPERATION PERMIT / EXISTING SYSTEM INSPECTION

DATE October 25, '99

PERMIT# 083343 PIN# 4706672037 (pt)

OWNER OR CONTRACTOR Crandell & O'Brien Const. PHONE: Business 871-1536 Home

ADDRESS 310 Treebark Rd. Statesville

LOCATION 90 West to TR Scotts Creek Rd X RR TL immediately on New Amity TR Westcott Mr. on left

SUBDIVISION Westcott BLOCK / SECTION LOT 3 LOT AREA ±7.36 Ac SITE CLASS PS DESIGN FLOW 360 gpd L.T.A.R. .3

Septic Tank: 1000 Gallons; STB 1012 Date 2-5-01

Pump Tank: Gallons; PT Date

Pump Make: Model Serial No.

Nitrification Field: No Fields 1 Square Feet 1200 Linear Feet 400

No Lines 3 @ 134' OR 4 @ 100' Trench Width 36" Max Trench Bottom Depth 36" Gravel Depth 12"

☑ New System ☐ Repair System Type: I (II) III. IV. V. VI

System Description: GRAVITY CONVENTIONAL

Repair System Description: GRAVITY/PUMPED CONVENTIONAL OR INNOVATIVE

Maintenance Agreement Required: ☐ Yes ☑ No

☑ House/Mod. Home No. Bedrooms 3

☐ Mobile Home No. Bathrooms 2

☐ Business No. Employees

☐ Other

☐ Slab ☑ Crawl Space ☐ Basement w/plumbing ☐ Basement w/o plumbing

Water Supply: ☐ Individual ☑ Public ☐ Community

Comments/Conditions:


Remove old berm/terrace.

Comments/Conditions: - Pump/Lok Filter Installed


- Septic Tank Marker Installed

1" = 50'

INITIAL SITE SKETCH

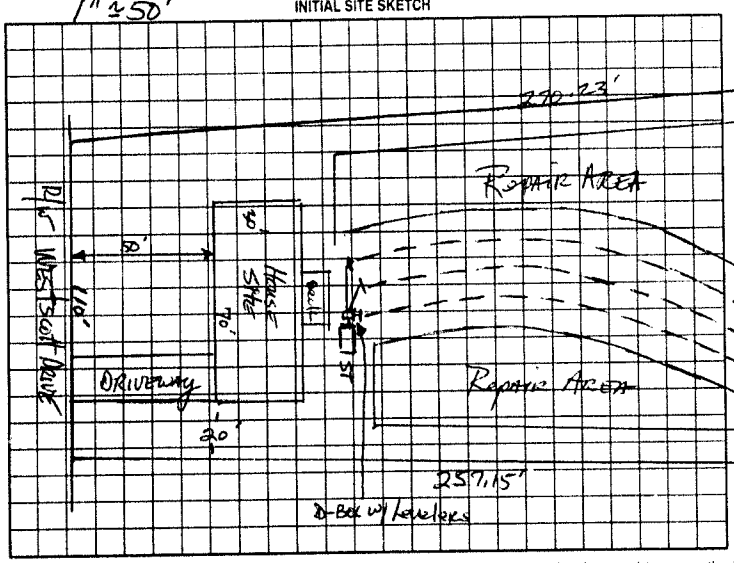


AS BUILT SKETCH

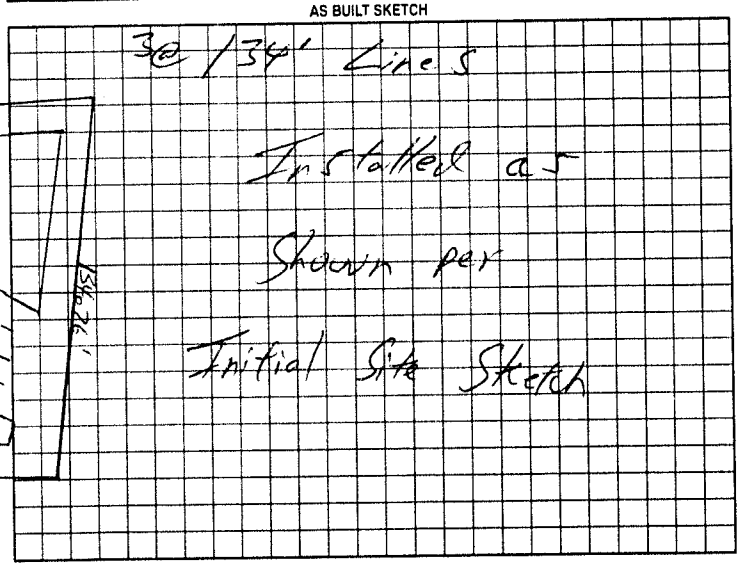


Permit can be suspended or revoked if any false information is supplied toward securing the permit/any unauthorized changes are made to the site/any unauthorized changes are made in the installation of the system. Improvement Permit with plat valid without expiration. Improvement Permit with site plan valid for sixty months. Authorization to Construct is valid for a period equal to that of Improvement Permit – not to exceed sixty months.

Signed: date 11-10-99 Installed by: A-1 Backhoe

Improvement Permit by: Ward Shumm, RS date 10-25-99 Operation Permit by: William C. Johnson date 4-9-01

Authorization to Construct by: STEVE HEDRICK date 11-13-00 Existing System Inspection by: date

HEALTH DEPT COPY WHITE OWNER COPY (FINAL) YELLOW OWNER COPY (INITIAL) PINK