IREDELL COUNTY HEALTH DEPARTMENT

STATESVILLE 704-878-5305 MOORESVILLE 704-664-5281

IMPROVEMENT PERMIT / AUTHORIZATION TO CONSTRUCT / OPERATION PERMIT / EXISTING SYSTEM INSPECTION

PERMIT# 81711 PIN# 4706618011 DATE June 11 99

OWNER OR CONTRACTOR James Snead PHONE: Business 704876 0166 Home

ADDRESS 115 Stanley Rd Statesville,

LOCATION Hwy 90 W on Left PAST Lippard Farm on Right from Scotts Creek going E.

SUBDIVISION BLOCK / SECTION LOT 2 LOT AREA .63 SITE CLASS. PS DESIGN FLOW 360 L.T.A.R. .3

Septic Tank: 1000 Gallons; STB 1007 Date 7/1999 ☐ New System ☐ Repair System Type: I (II) III, IV, V, VI

Pump Tank: Gallons; PT Date

Pump Make: Model Serial No.

Nitrification Field: No Fields 1 Square Feet 1200 Linear Feet 400

No Lines 4@100 Trench Width 36" Max Trench Bottom Depth 36"

System Description: GRAVITY CONV

Repair System Description: 50% Reduction / Pump

Maintenance Agreement Required: ☐ Yes ☒ No

Gravel Depth 12" ☐ Slab ☒ Crawl Space ☐ Basement w/plumbing ☐ Basement wo/plumbing

☐ House/Mod. Home No. Bedrooms 3

☒ Mobile Home A W No. Bathrooms 2

☐ Business No. Employees

☐ Other

Water Supply: ☐ Individual ☒ Public ☐ Community


Comments/Conditions: Install Lines on Contour

3 flow divider "Tees"


Scale 1" = 40'

Comments/Conditions

INITIAL SITE SKETCH

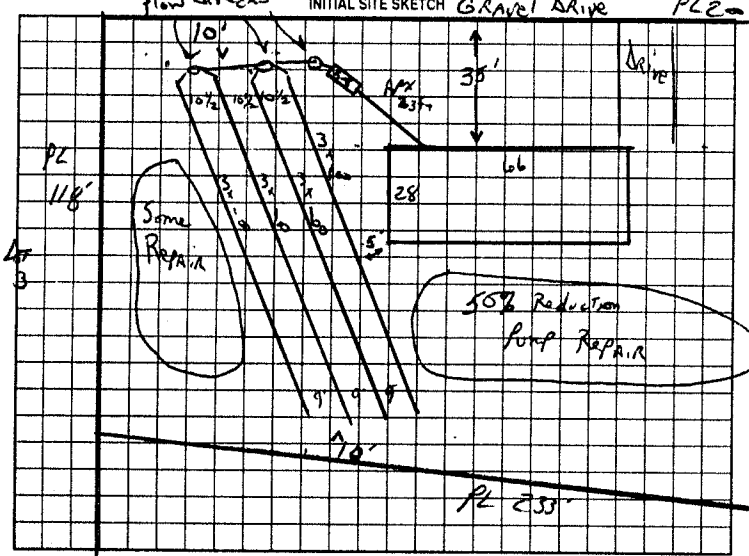

AS BUILT SKETCH

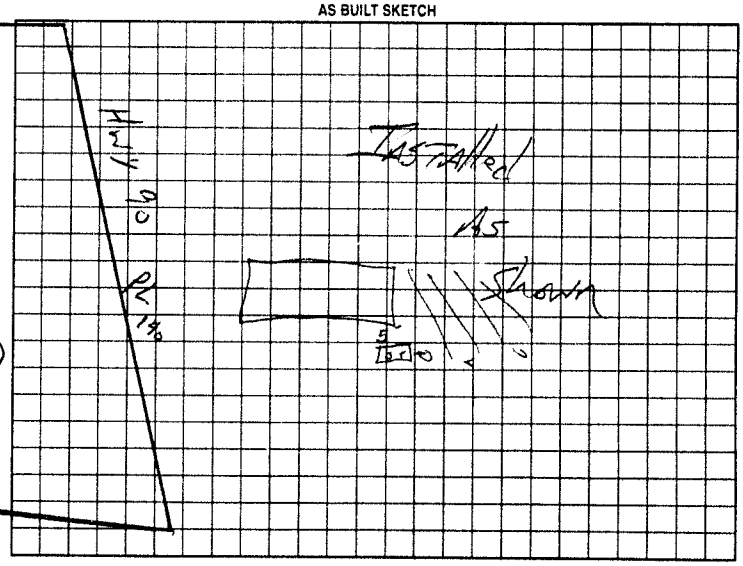

Permit can be suspended or revoked if any false information is supplied toward securing the permit/any unauthorized changes are made to the site/any unauthorized changes are made in the installation of the system. Improvement Permit with plat valid without expiration. Improvement Permit with site plan valid for sixty months. Authorization to Construct is valid for a period equal to that of Improvement Permit – not to exceed sixty months.

Signed: James D Snead date 6-11-99

Improvement Permit by: C Potter date June 11 99

Authorization to Construct by: C. Potter date June 11 99

Installed by: Jody TRAVIS

Operation Permit by: C Potter date Feb 25 2000

Existing System Inspection by: date

HEALTH DEPT. COPY: WHITE OWNER COPY (FINAL) YELLOW OWNER COPY (INITIAL) PINK