IREDELL COUNTY HEALTH DEPARTMENT

Statesville Phone TR 3-7271 Mooresville Phone NO 3-1271

PERMIT TO INSTALL SEPTIC TANK

Permit No. 15 — Permit Date Nov. 20 19 70

Owner New Amity ARP Church Parsonage Address _____

Installed By York Rufty Address Stony Point, NC.


Location of Property Highway 90 W. 1 mile Beyond Murdocks Service Sta. on Left.

Tank		Capacity		Length of Lines		Fixtures	
Block	( )	1000	(✓)	225'	( )	No. of Baths	(2)
Precast	(✓)	1250	( )	250'	( )	Dishwasher	( )
		1500	( )	Other 240		Garbage Grdr.	( )
		Other _____				Other _____	

NOTIFY HEALTH DEPARTMENT AT LEAST EIGHT HOURS BEFORE TANK IS TO BE INSPECTED.

Final Inspection Nov. 20 19 70 Approved (✓) Disapproved ( )

Remarks ALEXANDER WATER Corp

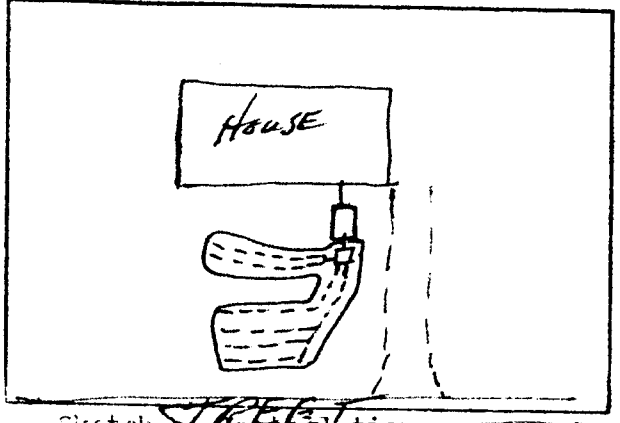

Sketch of Installation

Glenn Lodge

Sanitarian