EDELL COUNTY HEALTH DEPARTMENT STATESVILLE 704-878-5305 MOORESVILLE 704-664-5281

PROVEMENT PERMIT / AUTHORIZATION TO CONSTRUCT / OPERATION PERMIT / EXISTING SYSTEM INSPECTION

MIT# 076884 PIN# 4706 64 6930 DATE 4-13-99

ER OR CONTRACTOR K.W. NICHOLSON PHONE: Business Home 876-4359

RESS 182 MILLSTONE DRIVE, STATESVILLE, NC 28625

TION NC 90 W, TR SCOTT CREEK, TR LARKIN LANE, TR KANSAS, 1ST LOT ON LEFT

IVISION SCOTT CREEK BLOCK / SECTION LOT 32 LOT AREA 1.17 ACRES SITE CLASS DS DESIGN FLOW 360 L.T.A.R. 0.30 GPD/FT²

lic Tank: 1000 Gallons STB 1012 Date 2-3-99 | New System Repair System Type: (1) | House/Mod. Home No. Bedrooms 3 | Water Supply: Individual

ip Tank: Gallons PT Date | System Description: CONVENTIONAL GRAVITY | Mobile Home No. Bathrooms 2 | Public

ip Make: Model Serial No | Repair System Description: CONV. GRAVITY | Business No. Employees | Community

fication Field: lic Fields 1 Square Feet 1200 Linear Feet 400 | Maintenance Agreement Required Yes No | Other | Well


ines FIVE Trench Width 36" Max Trench Bottom Depth 36" Gravel Depth 12" | Slab Crawl Space Basement w/plumbing Basement w/o plumbing

ments/Conditions:

Comments/Conditions: SEPTIC TANK WITH RISER INSTALLED USING "POLYLOK" FILTER

INITIAL SITE SKETCH: CUL-DE-SAC

SCALE: 1"=50'

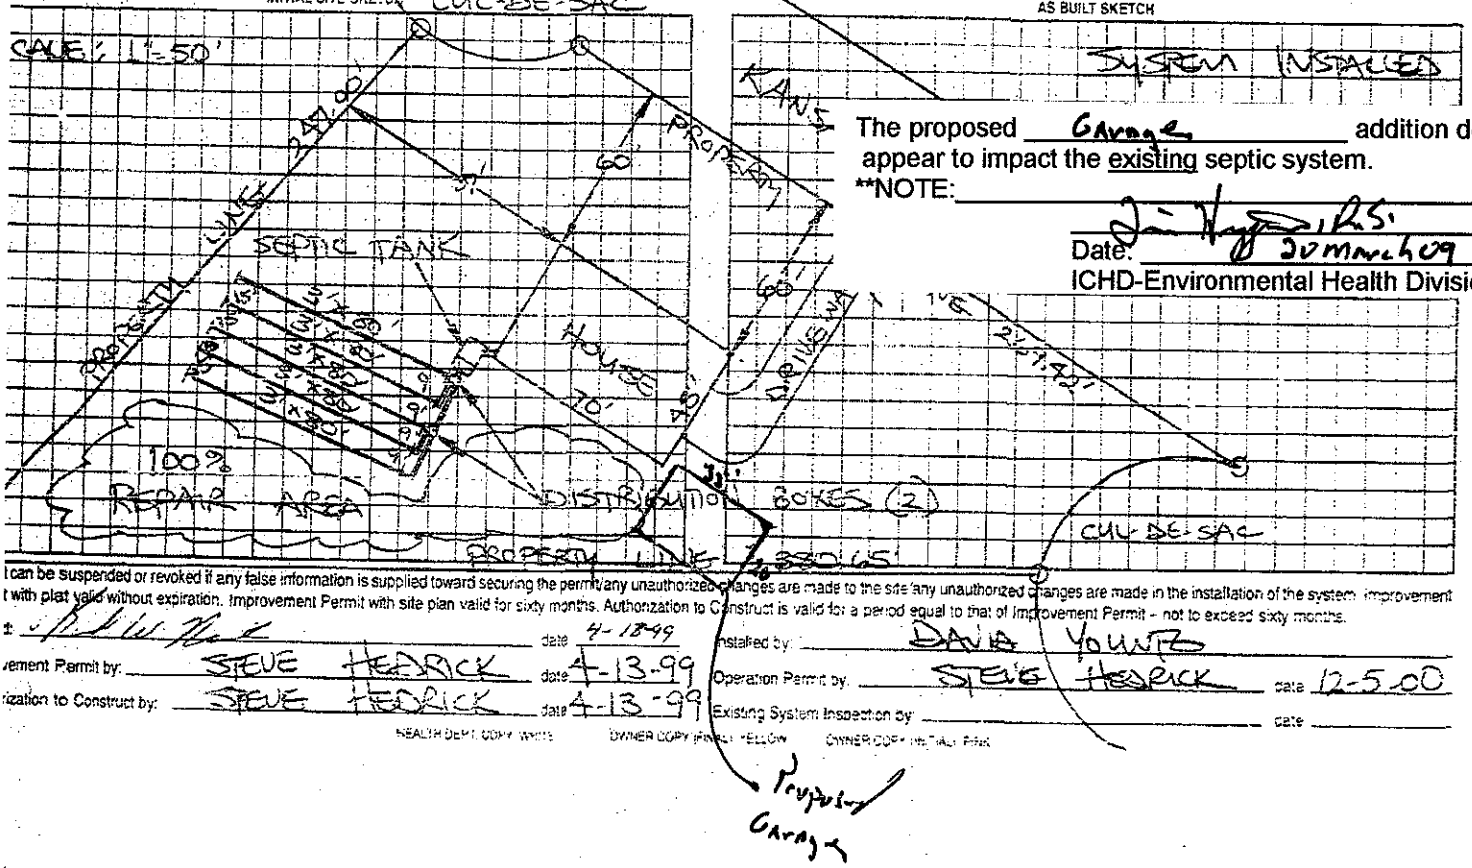

AS BUILT SKETCH

SYSTEM INSTALLED

KANSAS

The proposed Garage addition does not appear to impact the existing septic system.

**NOTE:

R.S.

Date: 30 March 09

ICHD-Environmental Health Division

I can be suspended or revoked if any false information is supplied toward securing the permit/any unauthorized changes are made to the site/any unauthorized changes are made in the installation of the system. Improvement t with plat valid without expiration. Improvement Permit with site plan valid for sixty months. Authorization to Construct is valid for a period equal to that of Improvement Permit - not to exceed sixty months.

t: date 4-13-99 Installed by: DAVE YOUNTS

vement Permit by: STEVE HEDRICK date 4-13-99 Operation Permit by: STEVE HEDRICK date 12-5-00

ization to Construct by: STEVE HEDRICK date 4-13-99 Existing System Inspection by: date

HEALTH DEPT. COPY WHITE OWNER COPY (PINK) YELLOW OWNER COPY (INITIAL) PINK

JAN. 16, 1989 9:54