IREDELL COUNTY HEALTH DEPARTMENT

STATESVILLE 704-878-5305 MOORESVILLE 704-664-5281

IMPROVEMENT PERMIT / AUTHORIZATION TO CONSTRUCT / OPERATION PERMIT / EXISTING SYSTEM INSPECTION

PERMIT# 079032 PIN# 4706 65 8776 DATE 1-28-99

OWNER OR CONTRACTOR ROBERTSON BUILDERS PHONE: Business Home 585-2735

ADDRESS 321 COUNTY LINE ROAD, STONY POINT, NC 28678

LOCATION NC 115 NORTH, TL SCOTTS CREEK ROAD, TR BROOMSAGE, 2ND LOT ON LEFT

SUBDIVISION BROOMSAGE BLOCK / SECTION I LOT 2 LOT AREA 0.502 ACRE SITE CLASS PS DESIGN FLOW 360 L.T.A.R. 0.30 GPD/FT²

Septic Tank: 1000 Gallons; STB 1012 Date 7-6-99
Pump Tank: 1000 Gallons; PT 17 Date 5-10-99
Pump Make: GOULDS Model EP0911A Serial No. H995-1840
Nitrification Field: No. Fields 1 Square Feet 1200 Linear Feet 400
No. Lines FOUR Trench Width 36" Max Trench Bottom Depth 36" Gravel Depth 12"

✓ New System Repair System Type: I. II (III.) IV. V. VI
System Description: CONVENTIONAL, PUMP
Repair System Description: PPBPS, LOW PRESS.
Maintenance Agreement Required: Yes ✓No


✓ House/Mod. Home No. Bedrooms 3
Mobile Home No. Bathrooms 2.5
Business No. Employees
Other
Slab ✓Crawl Space Basement w/plumbing Basement wo/plumbing

Water Supply: ☐ Individual ✓ Public ☐ Community

Comments/Conditions: SEE ATTACHED SHEETS FOR PUMP & PRESSURE MANIFOLD REQUIREMENTS

Comments/Conditions: SEPTIC TANK WITH RISERS INSTALLED USING "POLYLOK" FILTER ELECTRICAL BOX AND ALARM REMAIN TO BE INSPECTED

INITIAL SITE SKETCH SCALE: 1" = 40'

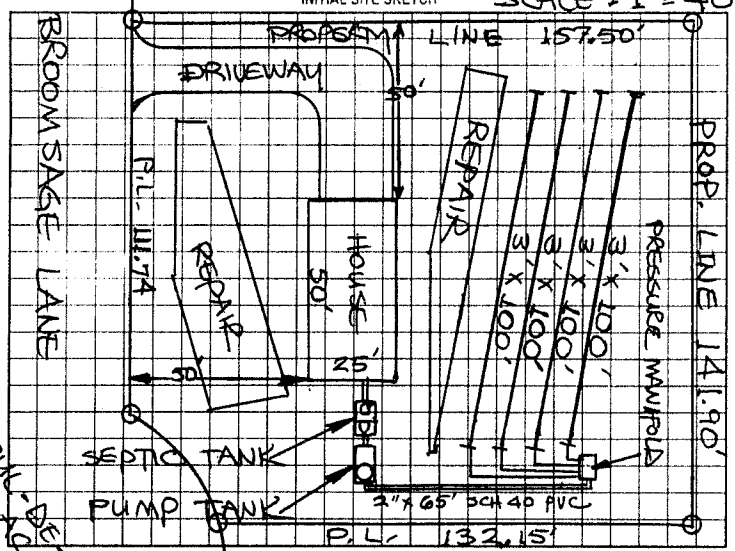

AS BUILT SKETCH

SYSTEM INSTALLED ACCORDING TO INITIAL SITE SKETCH

Permit can be suspended or revoked if any false information is supplied toward securing the permit/any unauthorized changes are made to the site/any unauthorized changes are made in the installation of the system. Improvement Permit with plat valid without expiration. Improvement Permit with site plan valid for sixty months. Authorization to Construct is valid for a period equal to that of Improvement Permit - not to exceed sixty months.

Signed: Robert Hilleton date 1-28-99 Installed by: TOMMY COMPTON

Improvement Permit by: STEVE HEDRICK date 1-28-99 Operation Permit by: STEVE HEDRICK date 9-23-99

Authorization to Construct by: STEVE HEDRICK date 1-28-99 Existing System Inspection by: date

HEALTH DEPT COPY WHITE OWNER COPY (FINAL) YELLOW OWNER COPY (INITIAL) PINK