IREDELL COUNTY HEALTH DEPARTMENT

STATESVILLE 704-878-5305 MOORESVILLE 704-664-5281

IMPROVEMENT PERMIT / AUTHORIZATION TO CONSTRUCT / OPERATION PERMIT / EXISTING SYSTEM INSPECTION

PERMIT# 115832 PIN# 4706-65-2818 DATE 10/6/03

OWNER OR CONTRACTOR Robertson Builders PHONE: Business (704) 682-1648 Home (704) 585-2735

ADDRESS 321 County Line Road Stony Point NC 28678

LOCATION Hwy 115 N (L) Scotts Creek Rd, (R) Broom Sage Lane, 3rd lot on the left

SUBDIVISION ~~Stony~~ Broomsage BLOCK / SECTION ___ LOT 3 LOT AREA .484 Ac. SITE CLASS. P8 DESIGN FLOW 480 L.T.A.R. .25

Septic Tank: 1,000 Gallons; STB 1007 Date 3-9-04
Pump Tank: 1,000 Gallons; PT 274 Date 2-10-04
Pump Make: ___ Model ___ Serial No. ___
Nitrification Field: No Fields 1 Square Feet Eq/430 Linear Feet 350
No Lines 7@50ft Trench Width 24" Max Trench Bottom Depth 36" ~~Gravel~~ Sand Depth 6"

☒ New System ☐ Repair System Type: I, II, (III), IV, V, VI
System Description: pump, ~~chamber~~ Panels
Repair System Description: pump - LPP
Maintenance Agreement Required: ☐ Yes ☒ No


☒ House/Mod. Home No. Bedrooms 4
☐ Mobile Home No. Bathrooms 2½
☐ Business No. Employees ___
☐ Other ___
☒ Slab ☐ Crawl Space ☐ Basement w/plumbing ☐ Basement wo/plumbing

Water Supply: ☐ Individual ☒ Public ☐ Community

Comments:/Conditions: ① Install 77 PP8PS (11/50ft Lns). ② Install lines on contour ③ See Attachments "A" "B" for pump + pressure manifold Information

Comments:/Conditions: - Lines okay, Pressure Check 4/27/04 GR - Zebel Filter Installed Electrical + Alarm okay

INITIAL SITE SKETCH

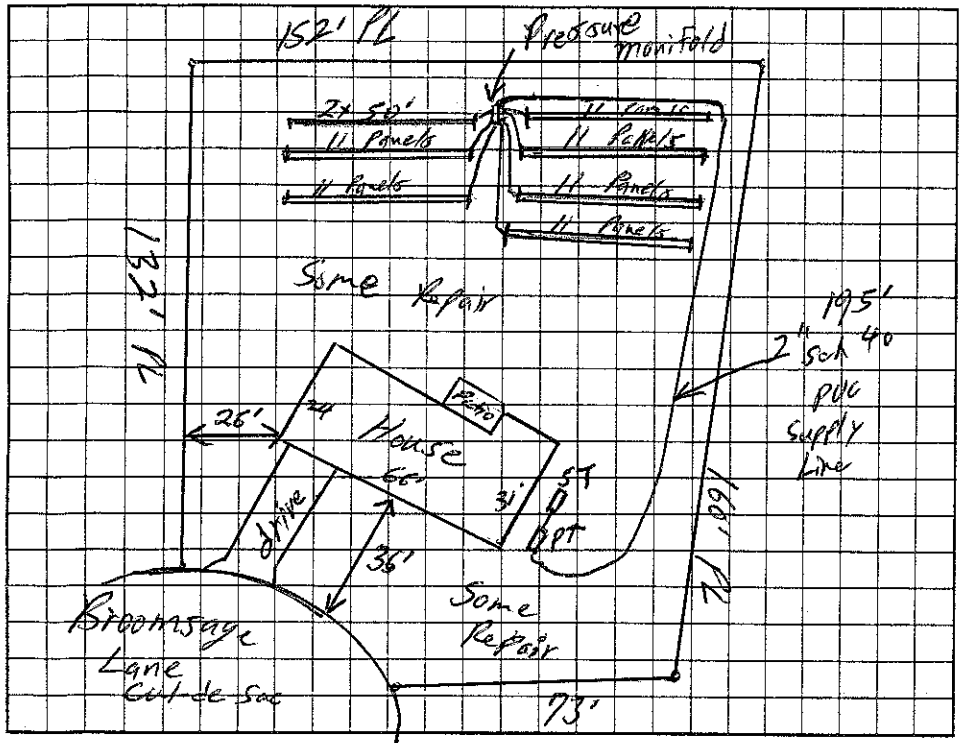

AS BUILT SKETCH

Installed As Shown Per Initial Site Sketch

Permit can be suspended or revoked if any false information is supplied toward securing the permit/any unauthorized changes are made to the site/any unauthorized changes are made in the installation of the system. Improvement Permit with plat valid without expiration, Improvement Permit with site plan valid for sixty months. Authorization to Construct is valid for a period equal to that of Improvement Permit – not to exceed sixty months.

Signed: Robert W. Robertson date 10/13/03 Installed by: Cothern + Son (4/26/04)

Improvement Permit by: William O. Johnson date 10/6/03 Operation Permit by: William O. Johnson date 4/28/04

Authorization to Construct by: William O. Johnson date 10/6/03 Existing System Inspection by: ___ date ___

HEALTH DEPT. COPY: WHITE OWNER COPY (FINAL): YELLOW OWNER COPY (INITIAL): PINK