# IREDELL COUNTY HEALTH DEPARTMENT

STATESVILLE 704-878-5305 MOORESVILLE 704-664-5281

## IMPROVEMENT PERMIT / AUTHORIZATION TO CONSTRUCT / OPERATION PERMIT / EXISTING SYSTEM INSPECTION

PERMIT# 069983 PIN# 4706 65 3120 DATE 3-11-98

OWNER OR CONTRACTOR K. W. NICHOLSON PHONE: Business 838-9729 Home 876-4359

ADDRESS 182 MILLSTONE DRIVE, STATESVILLE, NC 28625

LOCATION NC 115 N, TL SCOTTS CREEK ROAD TL LARKIN LANE, TR KANSAS LANE, AT END ON RIGHT

SUBDIVISION SCOTTS CREEK EST. BLOCK / SECTION II LOT 34 LOT AREA 1.138 ACRE SITE CLASS. PS DESIGN FLOW 360' L.T.A.R. 0.20 GPD/FT²

Septic Tank: 1000 Gallons; STB 1012 Date 9-19-98
Pump Tank: _____ Gallons; PT _____ Date _____
Pump Make: _____ Model _____ Serial No. _____
Nitrification Field: No Fields 1 Square Feet EST. TO 1800 Linear Feet 450+
No Lines FIVE Trench Width 36" Max Trench Bottom Depth 36" ~~Gravel~~ Depth SAND 6"

☑ New System ☐ Repair System Type: I, II, III, IV, V, VI
System Description: CHAMBERED GRAVITY
Repair System Description: CHAMBERED GRAVITY
Maintenance Agreement Required: ☐ Yes ☑ No

☑ House/Mod. Home No. Bedrooms 3
☐ Mobile Home No. Bathrooms 2
☐ Business No. Employees ____
☐ Other _____
☐ Slab ☑ Crawl Space ☐ Basement w/plumbing ☐ Basement wo/plumbing


Water Supply: ☑ Individual ☐ Public ☐ Community

Comments:/Conditions: ① SCOUR & LIME TRENCH SIDEWALLS PRIOR TO INSTALLING CHAMBERS ② INSTALL 75 CHAMBERS IN FIVE EQUAL LENGTH LINES ③ REMOVE EXISTING FIELD TERRACE

Comments:/Conditions:

INITIAL SITE SKETCH

SCALE: 1"=50'

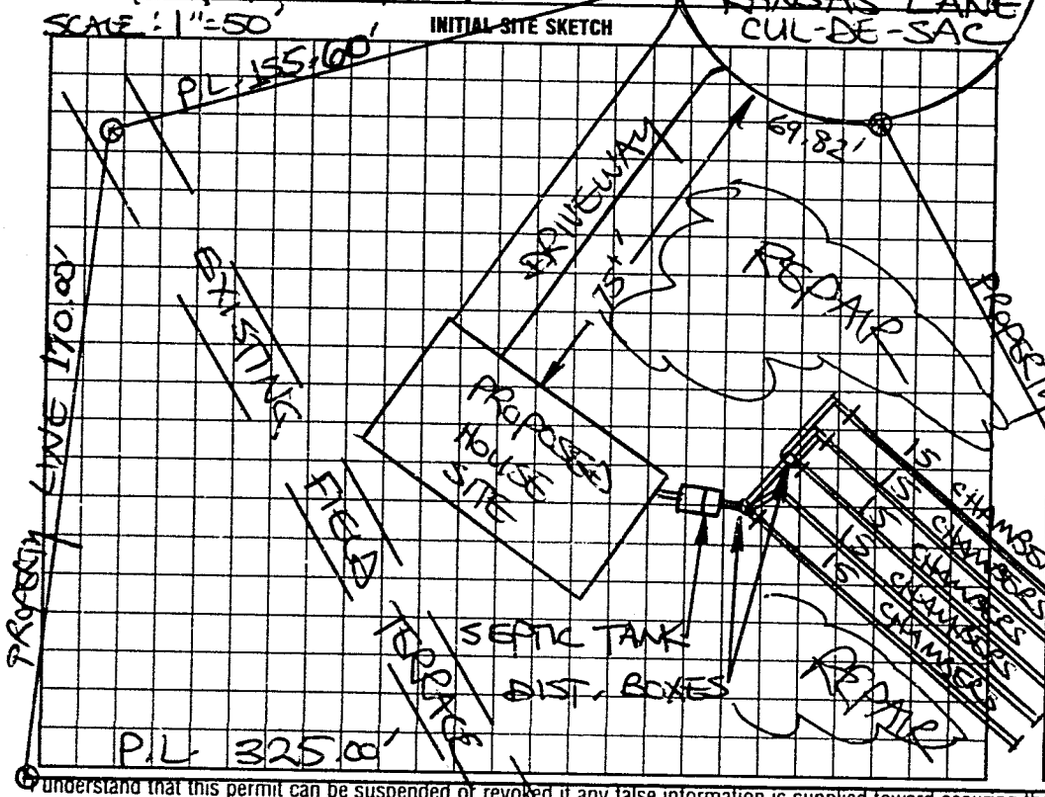


AS BUILT SKETCH

Same as initial Sketch

I understand that this permit can be suspended or revoked if any false information is supplied toward securing the permit/any unauthorized changes are made to the site/any unauthorized changes are made in the installation of the system. Improvement Permit with plat valid without expiration. Improvement Permit with site plan valid for sixty months. Authorization to Construct is valid for a period equal to that of Improvement Permit – not to exceed sixty months.

Signed: _____ date _____

Improvement Permit by: STEVE HEDRICK date 3-11-98

Authorization to Construct by: STEVE HEDRICK date 3-11-98

Installed by: Ethie Yountz & Sons

Operation Permit by: R. C. Moore date 11-25-98

Existing System Inspection by: _____ date _____

HEALTH DEPT COPY: WHITE INSPECTION COPY (FINAL) GREEN OWNER COPY (FINAL) YELLOW INSPECTION COPY (INITIAL) PINK OWNER COPY (INITIAL) GOLD