IREDELL COUNTY HEALTH DEPARTMENT

STATESVILLE 704-878-5305 MOORESVILLE 704-664-5281

IMPROVEMENT PERMIT / AUTHORIZATION TO CONSTRUCT / OPERATION PERMIT / EXISTING SYSTEM INSPECTION

PERMIT# 0699183 PIN# 4706 65 3120 DATE 3-11-98

OWNER OR CONTRACTOR K. W. NICHOLSON PHONE: Business 838-9729 Home 876-4359

ADDRESS 182 MILLSTONE DRIVE, STATESVILLE, NC 28625

LOCATION NC 115 N, TL SCOTTS CREEK ROAD TL LARKIN LANE, TR KANSAS LANE, AT END ON RIGHT

SUBDIVISION SCOTTS CREEK EST. BLOCK / SECTION II LOT 34 LOT AREA 1.138 ACRE SITE CLASS. PS DESIGN FLOW 360' L.T.A.R. 0.20 GPD/FT2

Septic Tank: 1000 Gallons; STB 1012 Date 9-17-98

Pump Tank: ____ Gallons; PT ____ Date ____

Pump Make: ____ Model ____ Serial No. ____

Nitrification Field: No Fields 1 Square Feet Est. to 1800 Linear Feet 450+

No Lines FIVE Trench Width 36" Max Trench Bottom Depth 36" Gravel Depth SAND 6"

☑ New System ☐ Repair System Type: I, II, III, IV, V, VI

System Description: CHAMBERED GRAVITY

Repair System Description: CHAMBERED GRAVITY

Maintenance Agreement Required: ☐ Yes ☑ No

☑ House/Mod. Home ☐ Mobile Home ☐ Business ☐ Other

No. Bedrooms 3 No. Bathrooms 2 No. Employees ____


☐ Slab ☑ Crawl Space ☐ Basement w/plumbing ☐ Basement wo/plumbing

Water Supply: ☑ Individual ☐ Public ☐ Community

Comments/Conditions: ① SCOUR & LIME TRENCH SIDEWALLS PRIOR TO INSTALLING CHAMBERS ② INSTALL 75 CHAMBERS IN FIVE EQUAL LENGTH LINES ③ REMOVE EXISTING FIELD TERRACE

Comments/Conditions:

INITIAL SITE SKETCH

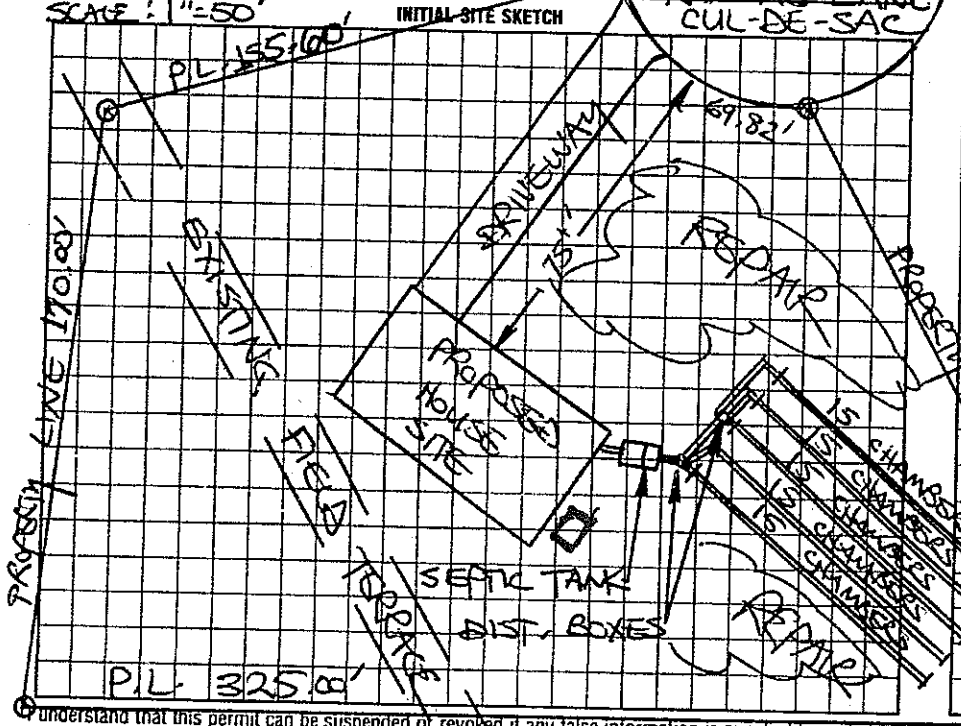

AS BUILT SKETCH

The location of the proposed Storage building 14x6' addition does not appear to impact the existing septic system. **NOTE: Same as initial sketch

REHS

Date: 5-14

ICHD-Environmental Health Division

I understand that this permit can be suspended or revoked if any false information is supplied toward securing the permit/any unauthorized changes are made to the site/any unauthorized changes are made in the installation of the system. Improvement Permit with plat valid without expiration. Improvement Permit with site plan valid for sixty months. Authorization to Construct is valid for a period equal to that of Improvement Permit – not to exceed sixty months.

Signed: [signature] date ____

Improvement Permit by: STEVE HEDRICK date 3-11-98

Authorization to Construct by: STEVE HEDRICK date 3-11-98

Installed by: Ethie Yountz & Sons

Operation Permit by: R. C. Moore date 11-25-98

Existing System Inspection by: ____ date ____

HEALTH DEPT COPY: WHITE INSPECTION COPY (FINAL) GREEN OWNER COPY (FINAL) YELLOW INSPECTION COPY (INITIAL) PINK OWNER COPY (INITIAL) GOLD