* Existing

IREDELL COUNTY HEALTH DEPARTMENT

STATESVILLE 704-878-5305 MOORESVILLE ~~704-664-5281~~

IMPROVEMENT PERMIT / AUTHORIZATION TO CONSTRUCT / OPERATION PERMIT / EXISTING SYSTEM INSPECTION

PERMIT # 158396 PIN # 4706-65-3259 DATE 1 October 09

OWNER or APPLICANT Thomas Justin Stikeleather PHONE ~~Business~~ Cell (704) 902-4711 Home:

OWNER or APPLICANT ADDRESS 1467 Scotts Creek Rd. Statesville NC.

LOCATION / DIRECTIONS

SUBDIVISION BLOCK / SECTION LOT # 2 LOT AREA DESIGN FLOW 360 gpd L.T.A.R.

Septic Tank 1000 Existing Gallons: STB Date

Pump Tank Gallons: P T Date

Pump Make Model Serial #

Nitrification Field No Fields 1 No Lines 6 Linear Feet 480

Trench Width Max. Trench Bottom Depth Gravel Depth 12

☐ New System ☐ Repair ☐ Expansion System Type I II III IV V VI

System Description: Conventional

Repair System Description:

Maintenance Agreement Required ☐ YES ☑ NO

☑ GRAVITY ☐ PRESSURE

☑ Residence No. Bedrooms 3

☐ Business No. Persons

☐ Other No. Employees

☐ Slab ☐ Crawl Space


☐ Basement w/plumbing ☐ Basement w/o plumbing

Water Supply: ☐ Private ☑ Public ☐ Community

Comments / Conditions: Scott Creek Rd.

Comments / Conditions

INITIAL SITE SKETCH

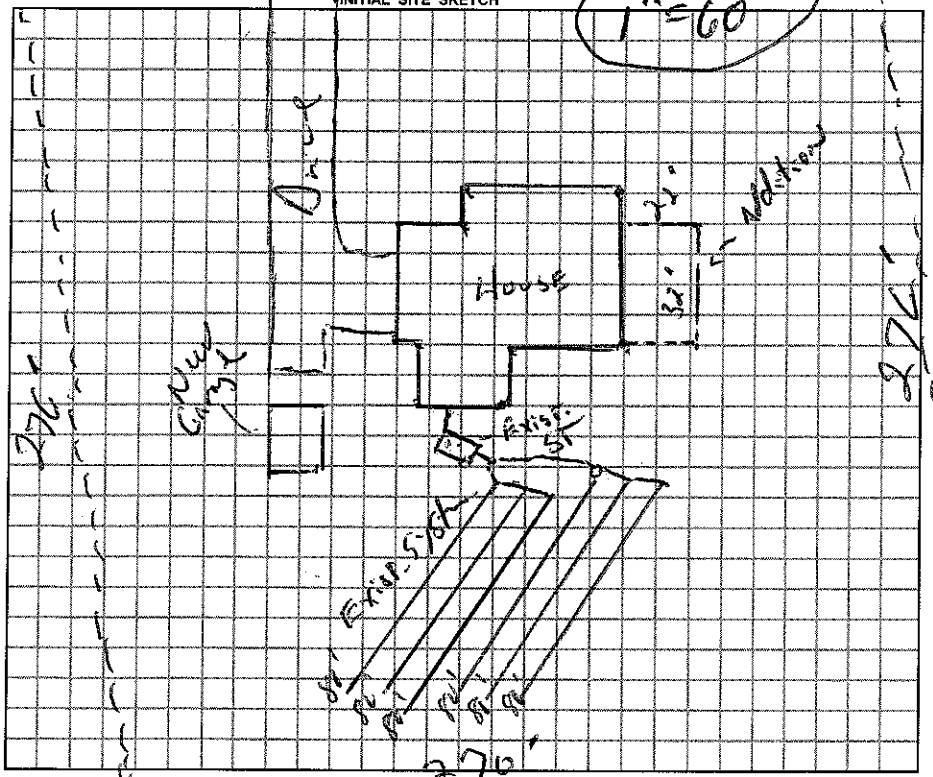

AS BUILT SKETCH

Permit can be suspended or revoked if any false information is supplied toward securing the permit / any unauthorized changes are made to the site / any unauthorized changes are made in the installation of the system.

☐ *IMPROVEMENT PERMIT w / plat valid without expiration.* ☐ *IMPROVEMENT PERMIT w / site plan valid for 60 mos.* ☐ *AUTHORIZATION TO CONSTRUCT valid for period equal to IMPROVEMENT PERMIT-not to exceed 60 mo.*

Owner / Applicant Signature: Thomas J Stikeleather Date 10/2/09

Improvement Permit by: Date

Authorzation to Construct by: Date

Installed by:

Operation Permit by: Date:

Existing System Inspected by: R.S. Date: 1 October 09

YOU SHOULD CONTACT A LOCATOR SERVICE PRIOR TO ANY EXCAVATION.

WHITE COPY Environmental Health YELLOW COPY (Initial) Owner / Applicant PINK COPY (Initial) Owner / Applicant