See attached permit #165814 for outbuilding addition 3/23/11 by owner (Millican)

IREDELL COUNTY HEALTH DEPARTMENT

STATESVILLE 704-878-5305 MOORESVILLE 704-664-5281

IMPROVEMENT PERMIT / AUTHORIZATION TO CONSTRUCT / OPERATION PERMIT / EXISTING SYSTEM INSPECTION

PERMIT# 13099-2 PIN# 4706-54-8228 DATE 10-20-06

OWNER OR APPLICANT Robertson Builders PHONE: Business 704-585-2235 Home

ADDRESS 321 Corral Line Road Stony Point NC 28678

LOCATION 115 N to Scotsdale (R) Broomsage lane Property at cul-de-sac

SUBDIVISION Broomsage BLOCK / SECTION 1 LOT 5 LOT AREA SITE CLASS 2S DESIGN FLOW 180 L.T.A.R. 13

Septic Tank: 1000 Gallons; STB 1007 Date 9-7-06
Pump Tank: Gallons; PT Date
Pump Make: Model Serial No.
Nitrification Field: No Fields Square Feet Liner Linear Feet 400
No Lines 6 Trench Width 36" Max Trench Bottom Depth 36" Gravel Depth N/A

☑ New System ☐ Repair ☐ Expansion System Type: I II III IV V VI
System Description: 2590 Conv. w/ Rock
Repair System Description: 2590 to Repair
Maintenance Agreement Required: ☐ Yes ☑ No

☑ House/Mod. Home No. Bedrooms 4
☐ Mobile Home No. Persons
☐ Business No. Employees
☐ Other


Water Supply: ☑ Individual ☐ Public ☐ Community

☑ Gravity ☐ Pressure ☐ Slab ☑ Crawl Space ☐ Basement w/plumbing ☐ Basement wo/plumbing

Comments/Conditions:
Install on Contour
Maintain all set backs

Comments/Conditions:
Line Length
1 90
2 88
3 76
4 68
5 60
6 14 - not Repair

INITIAL SITE SKETCH

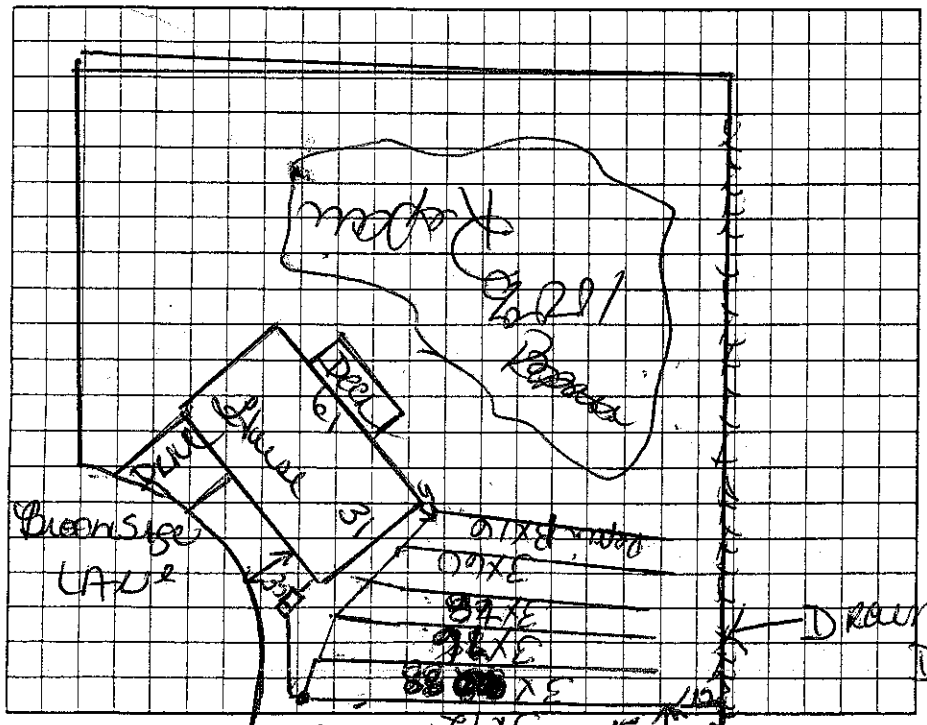

AS BUILT SKETCH

Permit can be suspended or revoked if any false information is supplied to obtain the permit/any unauthorized changes are made to the site/any unauthorized changes are made in the installation of the system. Improvement Permit with plat valid without expiration ☐ Improvement Permit with site plan valid for sixty months ☐ Authorization to Construct is valid for a period equal to that of Improvement Permit – not to exceed sixty months.

Signed: [signature] date 10-20-06 Installed by: Tommy Cothren

Improvement Permit by: Keith Cook date 10-20-06 Operation Permit by: Keith Cook date 10-20-06

Authorization to Construct by: Keith Cook date 10-20-06 Existing System Inspection by: date

HEALTH DEPT. COPY: WHITE OWNER COPY (FINAL): YELLOW OWNER COPY (INITIAL): PINK

6