IREDELL COUNTY HEALTH DEPARTMENT

STATESVILLE 704-878-5365 MOORESVILLE 704-664-5281

IMPROVEMENT PERMIT / AUTHORIZATION TO CONSTRUCT / OPERATION PERMIT / EXISTING SYSTEM INSPECTION

PERMIT# 13099 PIN# 4704-54-4827.17 DATE 10-20-06

OWNER OR APPLICANT Robertson Builders PHONE: Business 704-585-2235 Home

ADDRESS 321 Corral Lane Road Stony Point NC 28678

LOCATION 115 N to Scotsdale to Broomsage lane property at cul-de-sac

SUBDIVISION Broom Sage BLOCK / SECTION I LOT 5 LOT AREA SITE CLASS. RS DESIGN FLOW 480 L.T.A.R. 13

Septic Tank: 1000 Gallons; STB 1007 Date 9-7-06
Pump Tank: Gallons; PT Date
Pump Make: Model Serial No.
Nitrification Field: No Fields Square Feet 1400 Linear Feet 400
No Lines 6 Trench Width 36" Max Trench Bottom Depth 36" Gravel Depth NA

☐ New System ☐ Repair ☐ Expansion System Type: I II III IV V VI
System Description: 25% Reduction
Repair System Description: 25% Reduction
Maintenance Agreement Required: ☐ Yes ☑ No

☑ Gravity ☐ Pressure

☑ House/Mod. Home No. Bedrooms 4
☐ Mobile Home No. Persons
☐ Business No. Employees
☐ Other


Water Supply: ☑ Individual ☐ Public ☐ Community

☐ Slab ☑ Crawl Space ☐ Basement w/plumbing ☐ Basement wo/plumbing

Comments:/Conditions:
Install on Contour
Maintain all setback

Comments:/Conditions:
Line 1 98 Length
2 88
3 74
4 168
5 60
6 14 - not Repaired

INITIAL SITE SKETCH

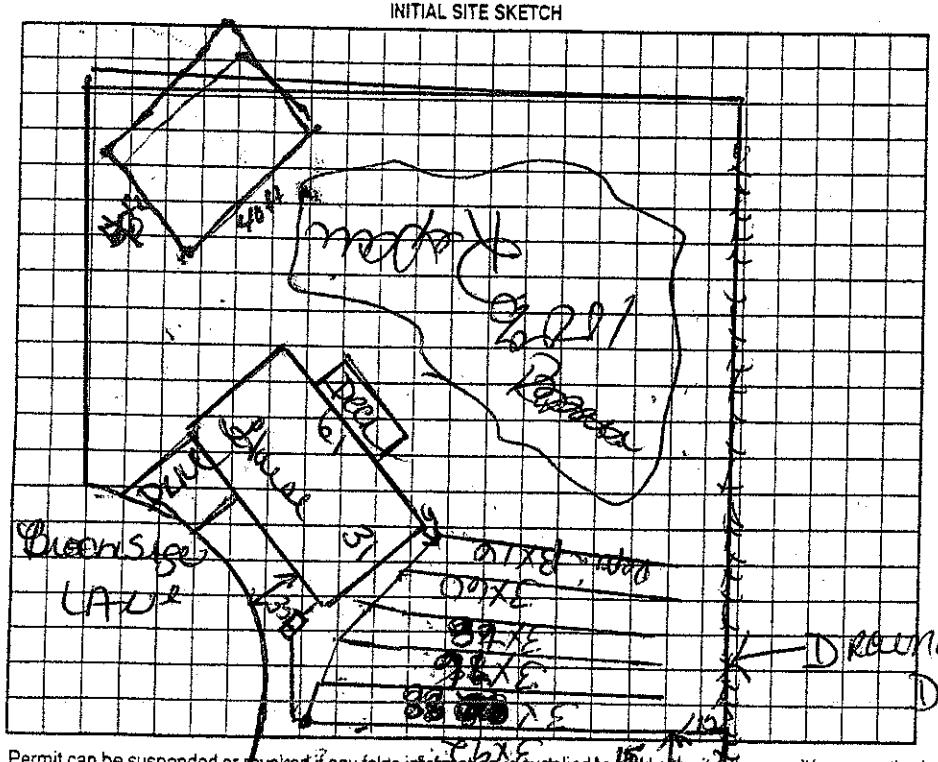

AS BUILT SKETCH

The location of the proposed Outbuilding 30-40 addition does not appear to impact the existing septic system.
**NOTE:
REHS
Date: 3-23-11
ICHD-Environmental Health Division

See attached

Permit can be suspended or revoked if any false information is supplied to and obtained the permit/any unauthorized changes are made to the site/any unauthorized changes are made in the installation of the system. Improvement Permit with plat valid without expiration ☐ Improvement Permit with site plan valid for sixty months ☐ Authorization to Construct is valid for a period equal to that of Improvement Permit – not to exceed sixty months.

Signed: date 10-20-06
Improvement Permit by: date 10-20-06
Authorization to Construct by: date 10-20-06

Installed by: Tommy Cothren
Operation Permit by: date 10-20-06
Existing System Inspection by: date

HEALTH DEPT. COPY: WHITE OWNER COPY (FINAL): YELLOW OWNER COPY (INITIAL): PINK

6