IREDELL COUNTY HEALTH DEPARTMENT

STATESVILLE 704-878-5305 MOORESVILLE 704-664-5281

IMPROVEMENT PERMIT / AUTHORIZATION TO CONSTRUCT / OPERATION PERMIT / EXISTING SYSTEM INSPECTION

PERMIT# 8337 PIN# 4706672037 (gf) DATE Jan 05, 01

OWNER OR CONTRACTOR Crandall & O'Brien Const. PHONE: Business 871-1536 Home

ADDRESS 310 Treabark Rd. Stat

LOCATION 90 West TR Scotts Cove Rd TL Lapp - New Amity TR Westcott Dr. on Right

SUBDIVISION Westcott BLOCK / SECTION LOT 2 LOT AREA .62 Ac SITE CLASS B DESIGN FLOW 360 gpd L.T.A.R. .3

Septic Tank: 1000 Gallons: STB 1012 Date 9-24-00
Pump Tank: Gallons: PT Date
Pump Make: Model Serial No.
Nitrification Field: No Fields 1 Square Feet 900 Linear Feet 300
No Lines 3 Trench Width 36" Max Trench Bottom Depth 36"

☑ New System ☐ Repair - System Type: I. II (III) IV. V. VI
System Description: Gravity Innovative 2 SFS Rock
Repair System Description: Innovative / Level 1 Soil
Maintenance Agreement Required: ☐ Yes ☑ No
Gravel Depth NA ☐ Slab ☑ Crawl Space ☐ Basement w/plumbing ☐ Basement wo/plumbing


☑ House/Mod. Home No. Bedrooms 3
☐ Mobile Home No. Bathrooms 2
☐ Business No. Employees
☐ Other

Water Supply: ☐ Individual ☒ Public ☐ Community


Comments/Conditions: Keep Trade shallow. Use aluminum pull to D Box.

Comments/Conditions: System installed using - 30 HDS Sections - Polylok filter installed / tank risers installed

INITIAL SITE SKETCH

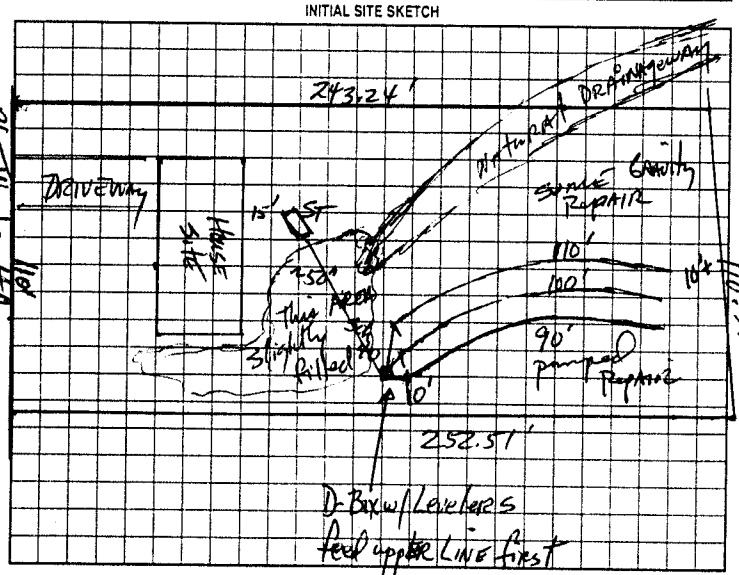

AS BUILT SKETCH

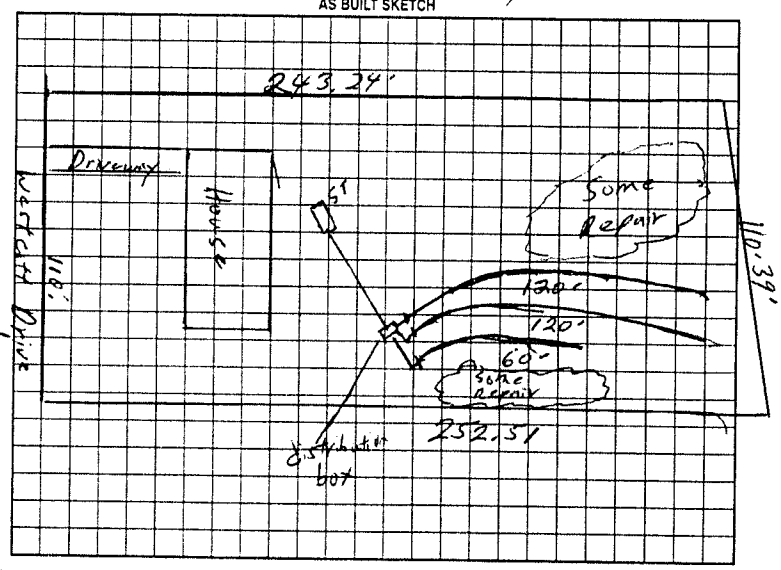

Permit can be suspended or revoked if any false information is supplied toward securing the permit/any unauthorized changes are made to the site/any unauthorized changes are made in the installation of the system. Improvement Permit with plat valid without expiration. Improvement Permit with site plan valid for sixty months. Authorization to Construct is valid for a period equal to that of Improvement Permit – not to exceed sixty months.

Signed: Richard Crandall date

Improvement Permit by: RS date 1-05-01

Authorization to Construct by: RS date 1-05-01

Installed by: A1 Backhoe

Operation Permit by: William Johnson REI date 11/6/01

Existing System Inspection by: date

HEALTH DEPT. COPY: WHITE OWNER COPY (FINAL): YELLOW OWNER COPY (INITIAL): PINK