IREDELL COUNTY HEALTH DEPARTMENT

STATESVILLE 704-878-5305 MOORESVILLE 704-664-5281

IMPROVEMENT PERMIT / AUTHORIZATION TO CONSTRUCT / OPERATION PERMIT / EXISTING SYSTEM INSPECTION

PERMIT# 083362 PIN# 4706672037 (pt) DATE Oct 5, '99

OWNER OR CONTRACTOR Crandall & O'Brian Const. PHONE: Business 871-1536 Home

ADDRESS 310 Trenbarke Rd Statesville

LOCATION 90 W TR Scotts Creek Rd TL New Cemetery Rd TR Westscott Drive on Right

SUBDIVISION Westscott BLOCK / SECTION LOT 22 LOT AREA .66 Ac SITE CLASS PS DESIGN FLOW 360 gpd L.T.A.R. .54

Septic Tank: 1000 Gallons; STB 1012 Date 5-13-2000 ☑ New System ☐ Repair System Type: I. II. III. IV. V. VI

Pump Tank: Gallons; PT Date System Description: GRAVITY CONVENTIONAL

Pump Make: Model Serial No. Repair System Description: (Pump) INNOVATIVE

Nitrification Field: No Fields 1 Square Feet 1200 Linear Feet 400 Maintenance Agreement Required: ☐ Yes ☑ No

No Lines 4@100' Trench Width 36" Trench Bottom Depth 36" Gravel Depth 12" ☐ Slab ☑ Crawl Space ☐ Basement w/plumbing ☐ Basement wo/plumbing

~~House/Mod. Home~~ No. Bedrooms 3

~~Mobile Home~~ No. Bathrooms 2

☐ Business No. Employees

☐ Other


Water Supply: ☐ Individual ~~Public~~ ☐ Community

Comments/Conditions: Remove Old Farm Burn
Install laterals at 36" trench bottom depth.

Comments/Conditions: SEPTIC TANK W/ RISERS INSTALLED USING "POLYLOK" FILTER

1" = 50'

INITIAL SITE SKETCH

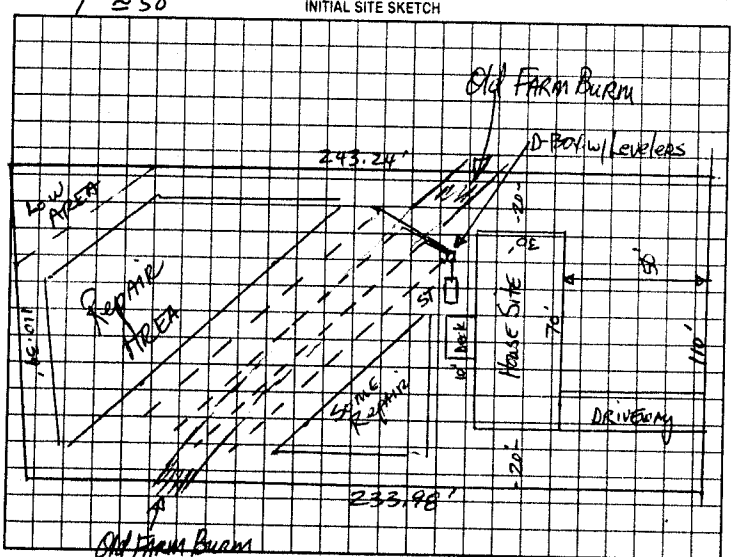

AS BUILT SKETCH

SYSTEM INSTALLED ACCORDING TO INITIAL SITE SKETCH

Permit can be suspended or revoked if any false information is supplied toward securing the permit/any unauthorized changes are made to the site/any unauthorized changes are made in the installation of the system. Improvement Permit with plat valid without expiration. Improvement Permit with site plan valid for sixty months. Authorization to Construct is valid for a period equal to that of Improvement Permit – not to exceed sixty months.

Signed: date

Improvement Permit by: date 10-5-99

Authorization to Construct by: STEVE HENDRICK date 6-13-2000

Installed by: A-1 BACKHOE

Operation Permit by: STEVE HENDRICK date 7-27-00

Existing System Inspection by: date

HEALTH DEPT COPY: WHITE OWNER COPY (FINAL) YELLOW OWNER COPY (INITIAL) PINK