# IREDELL COUNTY HEALTH DEPARTMENT

STATESVILLE 704-878-5305 MOORESVILLE 704-664-5281

## IMPROVEMENT PERMIT / AUTHORIZATION TO CONSTRUCT / OPERATION PERMIT / EXISTING SYSTEM INSPECTION

PERMIT# 083361 PIN# 4706672037 (pt) DATE Oct 5, '99

OWNER OR CONTRACTOR Crandall & O'Bryan Const. PHONE: Business 871-1536 Home

ADDRESS 310 Treebank Rd. Statesville

LOCATION 9 & W TR Scotts Creek Rd. TL New Amity Rd. TR Westscott Dr. on Right

SUBDIVISION Westscott BLOCK / SECTION LOT 19 LOT AREA .67ac SITE CLASS PS DESIGN FLOW 360gpd L.T.A.R. .3

Septic Tank: 1000 Gallons; STB 1012 Date 10-22-99
Pump Tank: Gallons; PT Date
Pump Make: Model Serial No.
Nitrification Field: No Fields 1 Square Feet 1200 Linear Feet 400
No Lines 4 @ 100 Trench Width 36" Trench Bottom Depth 36" Gravel Depth 12"

☑ New System ☐ Repair System Type: I, II, III, IV, V, VI
System Description: GRAVITY CONVENTIONAL
Repair System Description: GRAV/pumped INNOVATIVE
Maintenance Agreement Required: ☐ Yes ☑ No
☐ Slab ☑ Crawl Space ☐ Basement w/plumbing ☐ Basement wo/plumbing

☑ House/Mod. Home No. Bedrooms 3
☐ Mobile Home No. Bathrooms 2
☐ Business No. Employees
☐ Other


Water Supply: ☐ Individual ☒ Public ☐ Community

Comments/Conditions: Remove old FARM BURNS
Install laterals at 36" trench bottom depth.

Comments/Conditions SEPTIC TANK WITH RISERS AND MARKER INSTALLED USING "POLYLOK" FILTER

1" = 50'

INITIAL SITE SKETCH

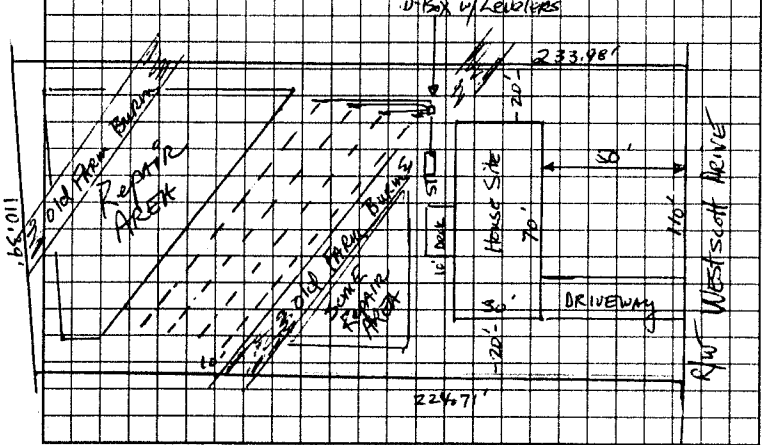


AS BUILT SKETCH

SYSTEM INSTALLED ACCORDING TO INITAL SITE SKETCH

Permit can be suspended or revoked if any false information is supplied toward securing the permit/any unauthorized changes are made to the site/any unauthorized changes are made in the installation of the system. Improvement Permit with plat valid without expiration. Improvement Permit with site plan valid for sixty months. Authorization to Construct is valid for a period equal to that of Improvement Permit - not to exceed sixty months.

~~Signed~~: date

Improvement Permit by: date 10-5-99

Authorization to Construct by: STEVE HEARICK date 10-6-99

Installed by: A-1 BACK HOE

Operation Permit by: STEVE HEARICK date 2-22-00

Existing System Inspection by: date

HEALTH DEPT. COPY. WHITE OWNER COPY (FINAL) YELLOW OWNER COPY (INITIAL) PINK