IREDELL COUNTY HEALTH DEPARTMENT

STATESVILLE 704-878-5305 MOORESVILLE 704-664-5281

IMPROVEMENT PERMIT / AUTHORIZATION TO CONSTRUCT / OPERATION PERMIT / EXISTING SYSTEM INSPECTION

PERMIT# 083360 PIN# 4706672037 (pt) DATE Nov. 9 '99

OWNER OR CONTRACTOR Crandall & O'Brien Const. PHONE: Business 871-1536 Home

ADDRESS 310 Treelawn Rd. Statesville

LOCATION 90 West TR Scotts Creek Rd. X RR immediately TL New County Rd TR Westcott Dr. on Right

SUBDIVISION Westcott BLOCK / SECTION LOT 18 LOT AREA ± .58 Ac SITE CLASS I's DESIGN FLOW 360 gpd L.T.A.R. .3

Septic Tank: 1000 Gallons; STB 1012 Date 8-1-99

Pump Tank: Gallons; PT Date

Pump Make: Model Serial No.

Nitrification Field: No Fields 1 Square Feet 900 ± Linear Feet 300 ±

No Lines 4 @ 75 ± Trench Width 36" Max Trench Bottom Depth 36" Gravel Depth

☑ New System ☐ Repair System Type: I II III IV V VI

System Description: Gravity Innovative -25% Reduction

Repair System Description: Exist/pumped/Innovative -

Maintenance Agreement Required: ☐ Yes ☑ No 25% Red.

☑ House/Mod. Home No. Bedrooms 3

☐ Mobile Home No. Bathrooms 2

☐ Business No. Employees

☐ Other


☐ Slab ☑ Crawl Space ☐ Basement w/plumbing ☐ Basement wo/plumbing

Water Supply: ☐ Individual ☒ Public ☐ Community

Comments/Conditions: Remove old Drains/Terraces & Drop Pipes may be used. * ENE INSPECTION APPT PER LATERALS

Comments Conditions: SEPTIC TANK W/ RISERS INSTALLED USING "POLY LOK" FILTER

INITIAL SITE SKETCH 1" = 50'

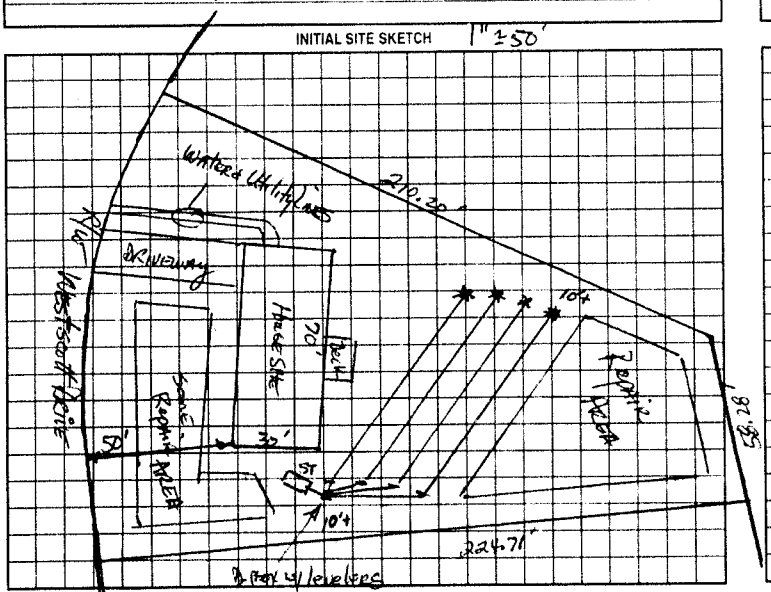

AS BUILT SKETCH

SYSTEM INSTALLED, USING CHAMBERS, ACCORDING TO INITAL SITE SKETCH

Permit can be suspended or revoked if any false information is supplied toward securing the permit/any unauthorized changes are made to the site/any unauthorized changes are made in the installation of the system. Improvement Permit with plat valid without expiration. Improvement Permit with site plan valid for sixty months. Authorization to Construct is valid for a period equal to that of Improvement Permit – not to exceed sixty months.

Signed: date 11-10-99

Improvement Permit by: date 11-9-99

Authorization to Construct by: STEVE HEDRICK date 2-1-00

Installed by: A-1 BACKHOE

Operation Permit by: STEVE HEDRICK date 5-17-00

Existing System Inspection by: date

HEALTH DEPT COPY WHITE OWNER COPY (FINAL) YELLOW OWNER COPY (INITIAL) PINK