IREDELL COUNTY HEALTH DEPARTMENT

STATESVILLE 704-878-5305 MOORESVILLE 704-664-5281

IMPROVEMENT PERMIT / AUTHORIZATION TO CONSTRUCT / OPERATION PERMIT / EXISTING SYSTEM INSPECTION

PERMIT# 083358 PIN# 470 667 2027 (pt) DATE October 30, '99

OWNER OR CONTRACTOR Crandell & O'Brien Const. PHONE: Business 871-1536 Home

ADDRESS 310 Treefarm Rd. Statesville

LOCATION 90 West TR Scotts Creek Rd. X RR immediately TL New County Rd. TR Westscott Dr. NEAR END ON Right

SUBDIVISION Westscott BLOCK / SECTION LOT 16 LOT AREA .5 ac. SITE CLASS PS DESIGN FLOW 360 gpd L.T.A.R. ~.3

Septic Tank: 1000 Gallons; STB 1012 Date 8-25-00
Pump Tank: Gallons, PT Date
Pump Make: Model Serial No.
Nitrification Field: No Fields 1 Square Feet 1200 Linear Feet 400
No Lines 4 @ 100 Trench Width 36" Max Trench Bottom Depth 36"

☑ New System ☐ Repair. System Type: I. II. III. IV. V. VI
System Description: GRAVITY CONVENTIONAL
Repair System Description: GRAV/pumped CONV/INNOVATIVE
Maintenance Agreement Required: ☐ Yes ☑ No
Gravel Depth 12"
☐ Slab ☑ Crawl Space ☐ Basement w/plumbing ☐ Basement wo/plumbing

☐ House/Mod. Home No. Bedrooms 3
☐ Mobile Home No. Bathrooms 2
☐ Business No. Employees
☐ Other


Water Supply: ☐ Individual ☑ Public ☐ Community

Comments/Conditions: Remove old barns / terraces. Drop Boxes may be used.

Comments/Conditions: SEPTIC TANK WITH RISERS INSTALLED USING "POLY LOK" FILTER

1" = 50'

INITIAL SITE SKETCH

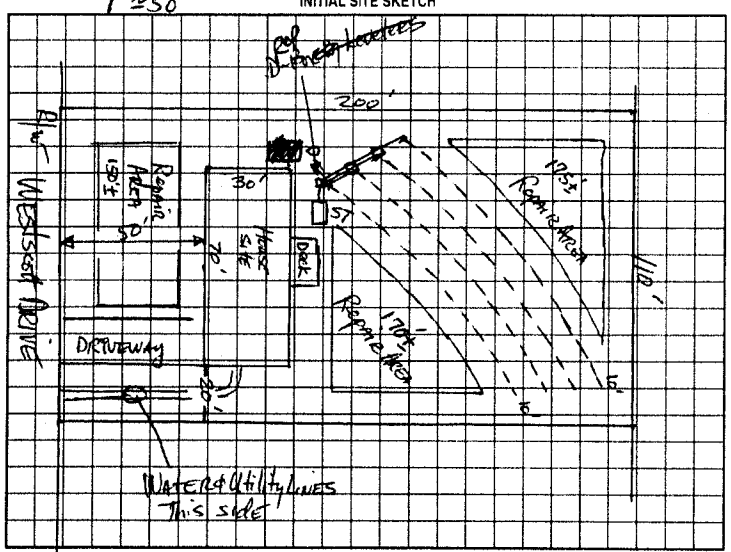

AS BUILT SKETCH

SYSTEM INSTALLED ACCORDING TO INITIAL SITE SKETCH

Permit can be suspended or revoked if any false information is supplied toward securing the permit/any unauthorized changes are made to the site/any unauthorized changes are made in the installation of the system. Improvement Permit with plat valid without expiration. Improvement Permit with site plan valid for sixty months. Authorization to Construct is valid for a period equal to that of Improvement Permit – not to exceed sixty months.

Signed: date 11-10-99 Installed by: A-1 BACKHOE

Improvement Permit by: date 10-30-99 Operation Permit by: STEVE HEDRICK date 10-6-00

Authorization to Construct by: STEVE HEDRICK date 7-24-00 Existing System Inspection by: date

HEALTH DEPT COPY WHITE OWNER COPY (FINAL) YELLOW OWNER COPY (INITIAL) PINK