IREDELL COUNTY HEALTH DEPARTMENT

STATESVILLE 704-878-5305 MOORESVILLE 704-664-5281

IMPROVEMENT PERMIT / AUTHORIZATION TO CONSTRUCT / OPERATION PERMIT / EXISTING SYSTEM INSPECTION

PERMIT# 083359 PIN# 4706672037 (pt.) DATE October 30, '99

OWNER OR CONTRACTOR Crandall & O'Briant Const PHONE: Business 871-1536 Home

ADDRESS 310 Treetrack Rd. Statesville

LOCATION 90 WEST TR Scotts Creek Rd X RR Immediately TL New Amity Pl. TR Westcott Dr. ON Right

SUBDIVISION Westcott BLOCK / SECTION LOT 17 LOT AREA .52 Ac SITE CLASS 15 DESIGN FLOW 360gpd L.T.A.R. .03

Septic Tank: 1000 Gallons; STB 1012 Date 8-15-00
Pump Tank: Gallons; PT Date
Pump Make: Model Serial No.
Nitrification Field: No Fields 1 Square Feet 900 Linear Feet 300
No Lines 4@75' Trench Width 36" Max Trench Bottom Depth 36" Gravel Depth N/A

☑ New System ☐ Repair System Type: I, II, III, IV, V, VI
System Description: Gravity Innovative -25% Red
Repair System Description: Grav/pump Innovative -25% Red
Maintenance Agreement Required: ☐ Yes ☑ No


~~House/Mod. Home~~ No. Bedrooms 3
☐ Mobile Home No. Bathrooms 2
☐ Business No. Employees
☐ Other
☐ Slab ☑ Crawl Space ☐ Basement w/plumbing ☐ Basement wo/plumbing

Water Supply: ☐ Individual ~~☑ Public~~ ☐ Community

Comments/Conditions: Remove old bricks/terraces!
* ONE INSPECTION PORT PER LATERAL

Comments/Conditions SEPTIC TANK WITH RISERS INSTALLED USING "PolyLok" FILTER

INITIAL SITE SKETCH

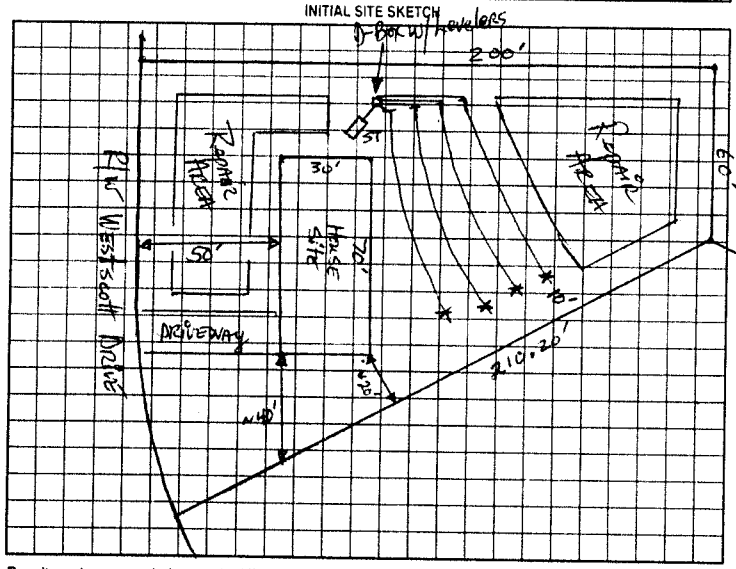

AS BUILT SKETCH

SYSTEM INSTALLED USING 50 "INFILTRATOR" CHAMBERS ACCORDING TO INITIAL SITE SKETCH

Permit can be suspended or revoked if any false information is supplied toward securing the permit/any unauthorized changes are made to the site/any unauthorized changes are made in the installation of the system. Improvement Permit with plat valid without expiration. Improvement Permit with site plan valid for sixty months. Authorization to Construct is valid for a period equal to that of Improvement Permit – not to exceed sixty months.

Signed: date 11-10-99 Installed by: A-1 BACKHOE

Improvement Permit by: date 11-30-99 Operation Permit by: STEVE HEDRICK date 10-6-00

Authorization to Construct by: STEVE HEDRICK date 7-18-2000 Existing System Inspection by: date

HEALTH DEPT COPY WHITE OWNER COPY (FINAL) YELLOW OWNER COPY (INITIAL) PINK