IREDELL COUNTY HEALTH DEPARTMENT

STATESVILLE 704-878-5305 MOORESVILLE 704-664-5281

IMPROVEMENT PERMIT / AUTHORIZATION TO CONSTRUCT / OPERATION PERMIT / EXISTING SYSTEM INSPECTION

PERMIT# 083357 PIN# 4706d72037 (pt) DATE October 30, 199

OWNER OR CONTRACTOR Crandall & O'Brien Constr PHONE: Business 871-1536 Home

ADDRESS 310 Treeberk Rd. Statesville

LOCATION 90 WEST TR Scotts Creek Rd. X RR immediately TL New Amity Rd TR Westcott Dr. 1st end on Right

SUBDIVISION Westscott BLOCK / SECTION LOT 15 LOT AREA .50 Ac SITE CLASS PS DESIGN FLOW 360gpd L.T.A.R. .34

Septic Tank: 1000 Gallons; STB 1012 Date 2-5-01
Pump Tank: Gallons; PT Date
Pump Make: Model Serial No.
Nitrification Field: No Fields 1 Square Feet 1200 Linear Feet 400
No Lines 4 @ 100' Trench Width 36" Max Trench Bottom Depth 36"

☑ New System ☐ Repair System Type: I II III IV V VI
System Description: GRAVITY CONVENTIONAL
Repair System Description: Gravity/pumped INNOVATIVE - 25% Red.
Maintenance Agreement Required: ☐ Yes ☐ No
Gravel Depth 12" ☐ Slab ☑ Crawl Space ☐ Basement w/plumbing ☐ Basement wo/plumbing


☑ House/Mod. Home No. Bedrooms 3
☐ Mobile Home No. Bathrooms 2
☐ Business No. Employees
☐ Other

Water Supply: ☐ Individual ☒ Public ☐ Community


Comments/Conditions: Remove old Propane / Terraces
Drop Boxes maybe used.

Comments/Conditions: -Poly Lok Filter Installed
-Septic Tank Marker Installed
-One (1) distribution box Installed

1" = 50' INITIAL SITE SKETCH

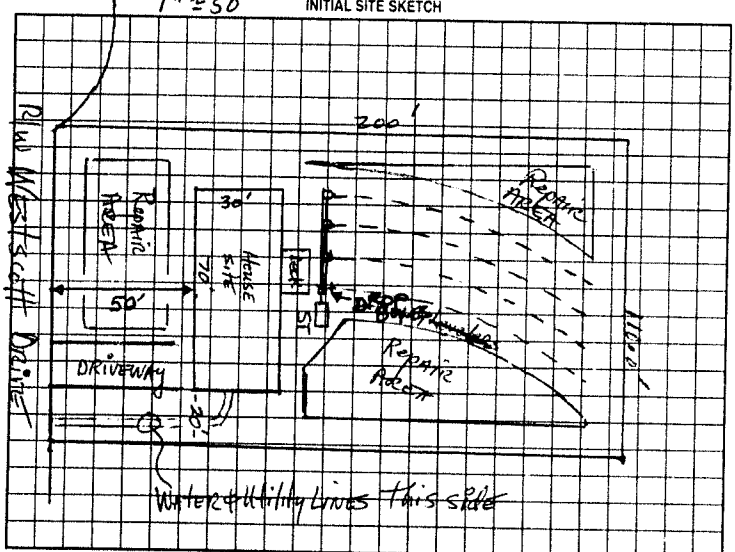

AS BUILT SKETCH

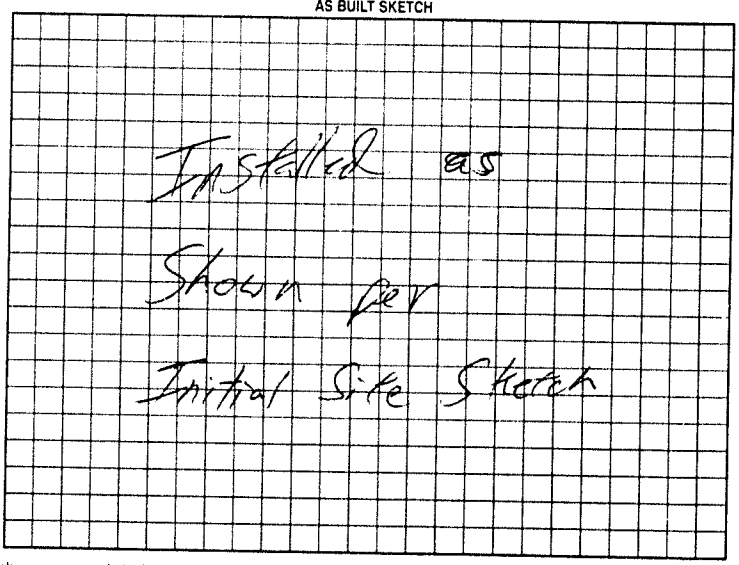

Permit can be suspended or revoked if any false information is supplied toward securing the permit/any unauthorized changes are made to the site/any unauthorized changes are made in the installation of the system. Improvement Permit with plat valid without expiration. Improvement Permit with site plan valid for sixty months. Authorization to Construct is valid for a period equal to that of Improvement Permit – not to exceed sixty months.

Signed: date 11-10-99 Installed by: Dennis Galliher

Improvement Permit by: Harold Thurman, RS date 10-30-99 Operation Permit by: William O. Johnson date 4/9/01

Authorization to Construct by: STEVE HEDRICK date 9-5-00 Existing System Inspection by: date

HEALTH DEPT COPY WHITE OWNER COPY (FINAL) YELLOW OWNER COPY (INITIAL) PINK