IREDELL COUNTY HEALTH DEPARTMENT

STATESVILLE 704-878-5305 MOORESVILLE 704-664-5281

IMPROVEMENT PERMIT / AUTHORIZATION TO CONSTRUCT / OPERATION PERMIT / EXISTING SYSTEM INSPECTION

PERMIT# 083356 PIN# 4706672037 (pt) DATE October 30, '99

OWNER OR CONTRACTOR Crandell & O'Brien Const. PHONE: Business 871-1536 Home

ADDRESS 310 Treebank Rd Statesville

LOCATION 90 WEST TR Scotts Creek Rd X RR immediately TL New Quarry Rd. TR Westscott Dr. At end on Right

SUBDIVISION Westscott BLOCK / SECTION LOT 14 LOT AREA .68Ac SITE CLASS IS DESIGN FLOW 360gpd L.T.A.R. 2 & 3

Septic Tank: 1000 Gallons; STB 1072 Date 3-12-01

Pump Tank: Gallons; PT Date

Pump Make: Model Serial No.

Nitrification Field: No Fields 1 Square Feet 900± Linear Feet 300±

No Lines 4@75' Trench Width 36" Max Trench Bottom Depth 40" Gravel Depth N/A

☐ New System ☐ Repair System Type: I, II, (III), IV, V, VI

System Description: GRAVITY INNOVATIVE -25% Red.

Repair System Description: SAME

Maintenance Agreement Required: ☐ Yes ☑ No

☐ House/Mod. Home No. Bedrooms 3

☐ Mobile Home No. Bathrooms 2

☐ Business No. Employees


☐ Other

☐ Slab ☑ Crawl Space ☐ Basement w/plumbing ☐ Basement wo/plumbing

Water Supply: ☐ Individual ☐ Public ☐ Community

Comments/Conditions: Remove All old Drains / Terraces!
* ONE INSPECTION PORT PER LATERAL
NOTE SEPTIC TANK Location - Exit plumbing Accordingly.
Drop Boxes may be used.

INITIAL SITE SKETCH 1" = 50'

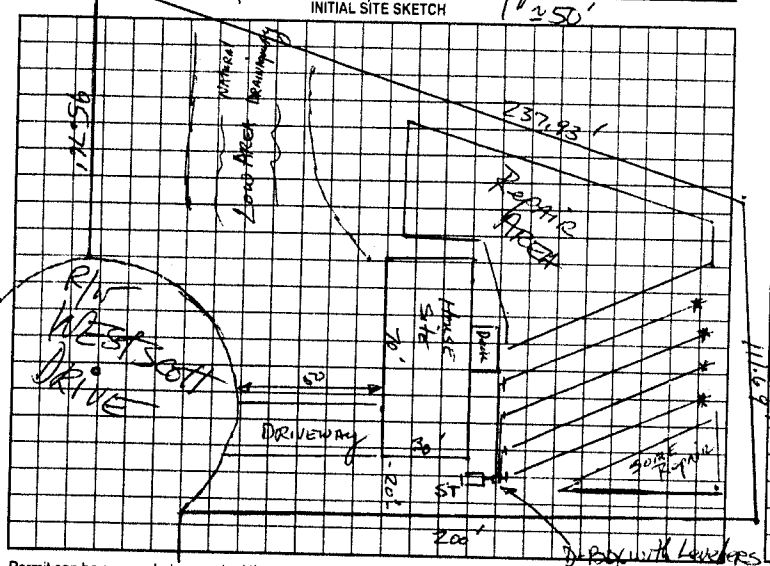

Comments/Conditions - poly/lok Filter Installed
- Septic Tank marker Installed
- 48 Infiltrator Chambers Installed
using distribution box
- Inspection laterals installed

AS-BUILT SKETCH

Installed as Shown per Initial Site Sketch

Permit can be suspended or revoked if any false information is supplied toward securing the permit/any unauthorized changes are made to the site/any unauthorized changes are made in the installation of the system. Improvement Permit with plat valid without expiration. Improvement Permit with site plan valid for sixty months. Authorization to Construct is valid for a period equal to that of Improvement Permit – not to exceed sixty months.

Signed: date 11-10-99 Installed by: A-1 Backhoe

Improvement Permit by: date 10-30-99 Operation Permit by: William O. Johnson RSI date 5/18/01

Authorization to Construct by: STEVE HEDRICK date 1-8-01 Existing System Inspection by: date

HEALTH DEPT COPY WHITE OWNER COPY (FINAL) YELLOW OWNER COPY (INITIAL) PINK