IREDELL COUNTY HEALTH DEPARTMENT

STATESVILLE 704-878-5305 ✓ MOORESVILLE 704-664-5281

IMPROVEMENT PERMIT / AUTHORIZATION TO CONSTRUCT / OPERATION PERMIT / EXISTING SYSTEM INSPECTION

PERMIT# 083352 PIN# 4706672037 (pt) DATE October 26, '99

OWNER OR CONTRACTOR Crandall & O'Brien Const. PHONE: Business 871-1536 Home

ADDRESS 310 Treefarm Rd. Statesville

LOCATION 90 West TR Scotts Creek Rd X RR immediately TL New Amity Rd, TR Westcott on left

SUBDIVISION Westcott BLOCK / SECTION LOT 10 LOT AREA 0.5Ac SITE CLASS. PS DESIGN FLOW 360gpd L.T.A.R. .03-.35

Septic Tank: 1000 Gallons; STB 1012 Date 9-1-01

Pump Tank: Gallons; PT Date

Pump Make: Model Serial No.

Nitrification Field: No Fields 1 Square Feet 1080 Linear Feet 360

No Lines 4@90' Trench Width 36" Max Trench Bottom Depth 36 Gravel Depth 12"

☑ New System ☐ Repair System Type: I. II. III. IV. V. VI

System Description: Gravity Conventional

Repair System Description: Gravity Innovative -25%

Maintenance Agreement Required: ☐ Yes ☑ No Red.

☐ House/Mod. Home ☐ Mobile Home ☐ Business ☐ Other

No. Bedrooms 3 No. Bathrooms 2 No. Employees

☐ Slab ☑ Crawl Space ☐ Basement w/plumbing ☐ Basement wo/plumbing


Water Supply: ☐ Individual ☑ Public ☐ Community

Comments/Conditions: Remove old burns/Terraces


Comments/Conditions:
- Poly Lok Filter Installed
- Septic Tank Marker Installed

1" = 50'

INITIAL SITE SKETCH

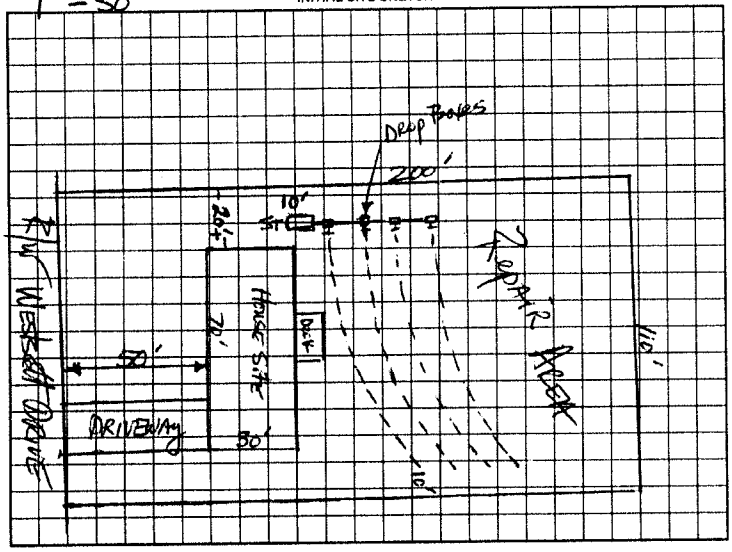

AS BUILT SKETCH

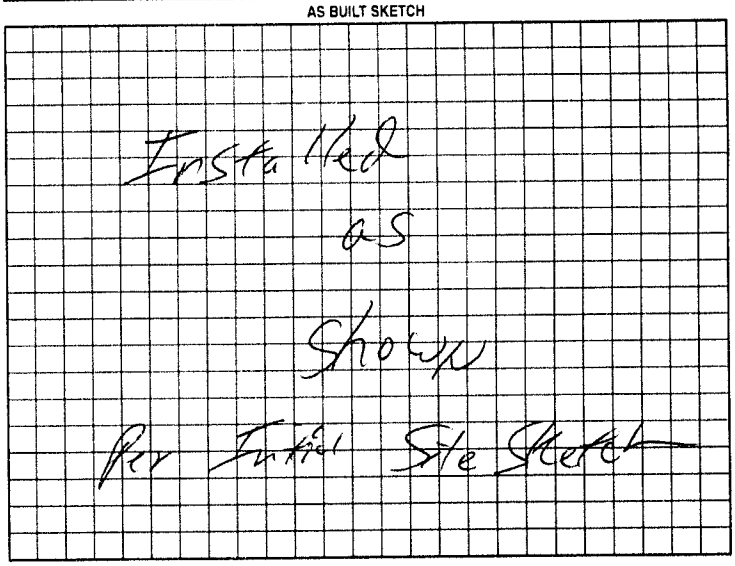

Permit can be suspended or revoked if any false information is supplied toward securing the permit/any unauthorized changes are made to the site/any unauthorized changes are made in the installation of the system. Improvement Permit with plat valid without expiration. Improvement Permit with site plan valid for sixty months. Authorization to Construct is valid for a period equal to that of Improvement Permit – not to exceed sixty months.

Signed: date 11-10-99 Installed by: A-1 Backhoe

Improvement Permit by: date 10-26-99 Operation Permit by: date 11/5/01

Authorization to Construct by: STEVEN HEDRICK date 6-27-01 Existing System Inspection by: date

HEALTH DEPT. COPY: WHITE OWNER COPY (FINAL): YELLOW OWNER COPY (INITIAL): PINK