IREDELL COUNTY HEALTH DEPARTMENT

STATESVILLE 704-878-5305 MOORESVILLE 704-664-5281

IMPROVEMENT PERMIT / AUTHORIZATION TO CONSTRUCT / OPERATION PERMIT / EXISTING SYSTEM INSPECTION

PERMIT# 083354 PIN# 4706672037 (Lot 1) DATE October 27, '99

OWNER OR CONTRACTOR Crandall & O'Brien Const. PHONE: Business 871-1536 Home

ADDRESS 310 Treebank Rd. Statesville

LOCATION 90 WEST TR Scotts Creek Rd X RR immediately TL New Amity Rd TR Westscott Dr. on left at end

SUBDIVISION Westscott BLOCK / SECTION LOT 12 LOT AREA .487ac SITE CLASS PS DESIGN FLOW 360gpd L.T.A.R. .3

Septic Tank: 1000 Gallons; STB 1012 Date 4-1-00
Pump Tank: Gallons; PT Date
Pump Make: Model Serial No.
Nitrification Field: No Fields 1 Square Feet 900 Linear Feet 300
No Lines 3@100' Trench Width 36" Max Trench Bottom Depth 36"

☑ New System ☐ Repair System Type: I. II (III) IV. V. VI
System Description: GRAVITY INNOVATIVE -25% Red
Repair System Description: Gravity/pumped INNOVATIVE
Maintenance Agreement Required: ☐ Yes ☑ No
Gravel Depth N/A ☐ Slab ☑ Crawl Space ☐ Basement w/plumbing ☐ Basement wo/plumbing


☑ House/Mod. Home No. Bedrooms 3
☐ Mobile Home No. Bathrooms 2
☐ Business No. Employees
☐ Other

Water Supply:
☐ Individual
☑ Public
☐ Community

Comments/Conditions: * ONE Inspection port per LATERAL
HAS 2012 HORIZONTAL may be best option due to contours.
REMOVE old burns/TERRACES!

INITIAL SITE SKETCH

1" ≈ 50'

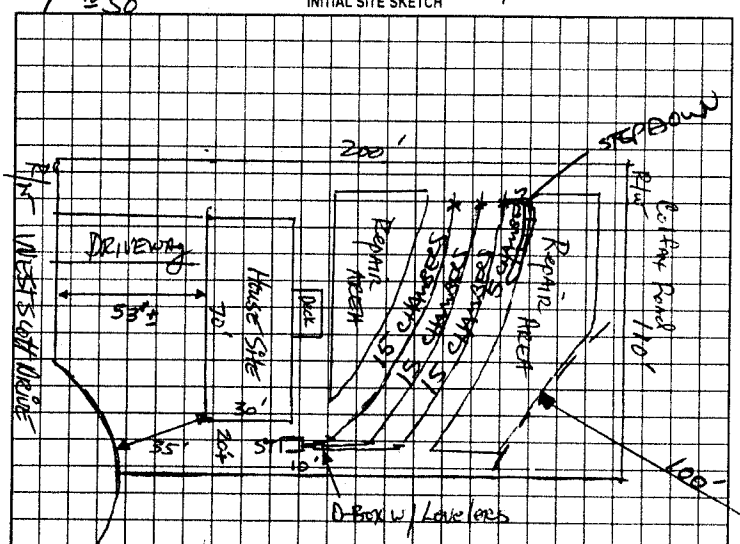

Comments/Conditions: SEPTIC TANK W/ RISERS INSTALLED USING "POLYLOK" FILTER

AS BUILT SKETCH

SYSTEM INSTALLED AS SHOWN USING FIFTY (50) "INFILTRATOR" CHAMBERS.

Permit can be suspended or revoked if any false information is supplied toward securing the permit/any unauthorized changes are made to the site/any unauthorized changes are made in the installation of the system. Improvement Permit with plat valid without expiration. Improvement Permit with site plan valid for sixty months. Authorization to Construct is valid for a period equal to that of Improvement Permit – not to exceed sixty months.

Signed: date 11-10-99 Installed by: A-1 BACKHOE

Improvement Permit by: date 10-27-99 Operation Permit by: STEVE HEDRICK date 7-26-00

Authorization to Construct by: STEVE HEDRICK date 5-3-00 Existing System Inspection by: date

HEALTH DEPT COPY WHITE OWNER COPY (FINAL) YELLOW OWNER COPY (INITIAL) PINK