IREDELL COUNTY HEALTH DEPARTMENT

STATESVILLE 704-878-5305 MOORESVILLE 704-664-5281

IMPROVEMENT PERMIT / AUTHORIZATION TO CONSTRUCT / OPERATION PERMIT / EXISTING SYSTEM INSPECTION

PERMIT# 083353 PIN# 4706672037 (pt) DATE October 27, 1999

OWNER OR CONTRACTOR Crandall & O'Brien Const PHONE: Business 871-1536 Home

ADDRESS 310 Tarebank Rd Statesville

LOCATION 90 WEST TR Scotts Creek Rd X RR Immediately TL New County Rd TR Westscott Dr on left

SUBDIVISION Westscott BLOCK / SECTION LOT 11 LOT AREA .5AC SITE CLASS PS DESIGN FLOW 360gpd L.T.A.R. .3+.35

Septic Tank: 1000 Gallons; STB 1012 Date 2-27-00

Pump Tank: Gallons; PT Date

Pump Make: Model Serial No.

Nitrification Field: No Fields 1 Square Feet 1080 Linear Feet 360

No Lines 4@90+ Trench Width 36" Max Trench Bottom Depth 36"

☑ New System ☐ Repair System Type: I (II) III IV V VI

System Description: Gravity conventional

Repair System Description: ~~Gravity~~ INNOVATIVE 25% Red.

Maintenance Agreement Required: ☐ Yes ☑ No

Gravel Depth 12" ☐ Slab ☑ Crawl Space ☐ Basement w/plumbing ☐ Basement wo/plumbing

☐ House/Mod. Home No. Bedrooms 3

☐ Mobile Home No. Bathrooms 2

☐ Business No. Employees

☐ Other


Water Supply: ☐ Individual ☑ Public ☐ Community

Comments/Conditions: Remove old burma / Terraceseo

Comments/Conditions: SEPTIC TANK W/ RISERS & MARKER INSTALLED USING "PolyLok" FILTER

1" = 50'

INITIAL SITE SKETCH

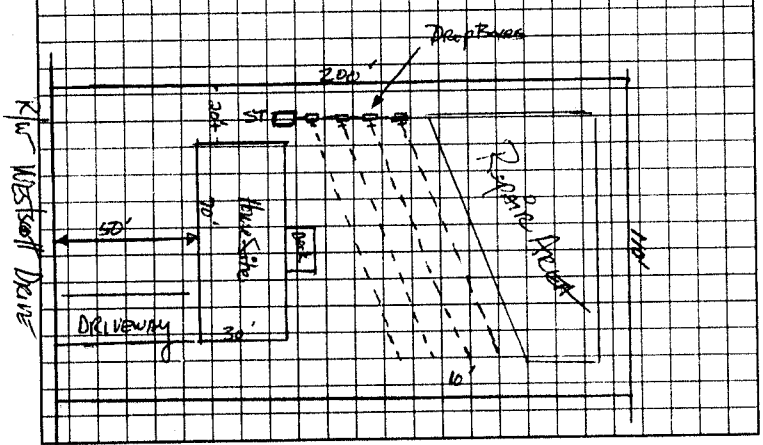

AS BUILT SKETCH

SYSTEM INSTALLED ACCORDING TO INITIAL SITE SKETCH

Permit can be suspended or revoked if any false information is supplied toward securing the permit/any unauthorized changes are made to the site/any unauthorized changes are made in the installation of the system. Improvement Permit with plat valid without expiration. Improvement Permit with site plan valid for sixty months. Authorization to Construct is valid for a period equal to that of Improvement Permit – not to exceed sixty months.

Signed: date 11-10-99 Installed by: A-1 BACKHOE

Improvement Permit by: date 10-27-99 Operation Permit by: STEVE HEDRICK date 5-17-00

Authorization to Construct by: STEVE HEDRICK date 11-15-99 Existing System Inspection by: date

HEALTH DEPT COPY WHITE OWNER COPY (FINAL) YELLOW OWNER COPY (INITIAL) PINK