IREDELL COUNTY HEALTH DEPARTMENT

STATESVILLE 704-878-5305 MOORESVILLE 704-664-5281

IMPROVEMENT PERMIT / AUTHORIZATION TO CONSTRUCT / OPERATION PERMIT / EXISTING SYSTEM INSPECTION

PERMIT# OB3355 PIN# 4706672037 (pt) DATE October 30, 99

OWNER OR CONTRACTOR Crandall & O'Brien PHONE: Business 871-1536 Home

ADDRESS 310 Treebank Rd. Statesville

LOCATION 90 WEST TR Scotts Creek Rd XRR immediately TL New County RD TR Westcott Dr ATERM on left

SUBDIVISION WEST Scott BLOCK / SECTION LOT 13 LOT AREA .90 Ac SITE CLASS PS DESIGN FLOW 360 gpd L.T.A.R. .025 +

Septic Tank: 1000 Gallons: STB 1012 Date 2-27-00
Pump Tank: Gallons: PT Date
Pump Make: Model Serial No.
Nitrification Field: No Fields 1 Square Feet 1440 Linear Feet 480
No Lines 5 Trench Width 36" Trench Bottom Depth 36" Gravel Depth 12"

☑ New System ☐ Repair System Type: ☐ I ☑ III, IV, V, VI
System Description: GRAVITY CONVENTIONAL
Repair System Description: SAME
Maintenance Agreement Required: ☐ Yes ☑ No
☐ Slab ☑ Crawl Space ☐ Basement w/plumbing ☐ Basement wo/plumbing


☑ House/Mod. Home No. Bedrooms 3
☐ Mobile Home No. Bathrooms 2
☐ Business No. Employees
☐ Other

Water Supply: ☐ Individual ☑ Public ☐ Community


Comments/Conditions: REMOVE all old burns/TERRACES
May use single D-Box with leveler's.
XX Installer, NOTE Septic TANK Location and TRENCH Bottom Depth.

Comments/Conditions: SEPTIC TANK INSTALLED DEEP USING MARKER & "POLY LOK" FILTER

INITIAL SITE SKETCH

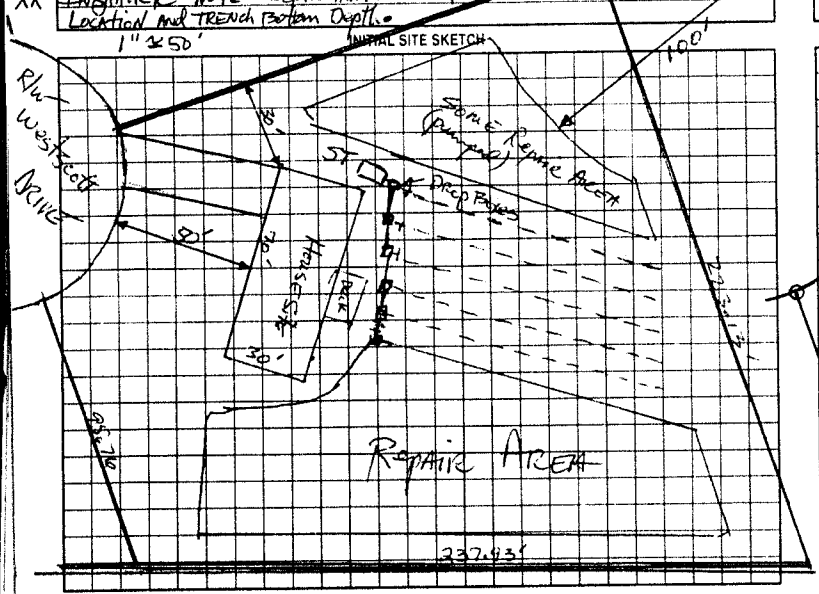

AS BUILT SKETCH

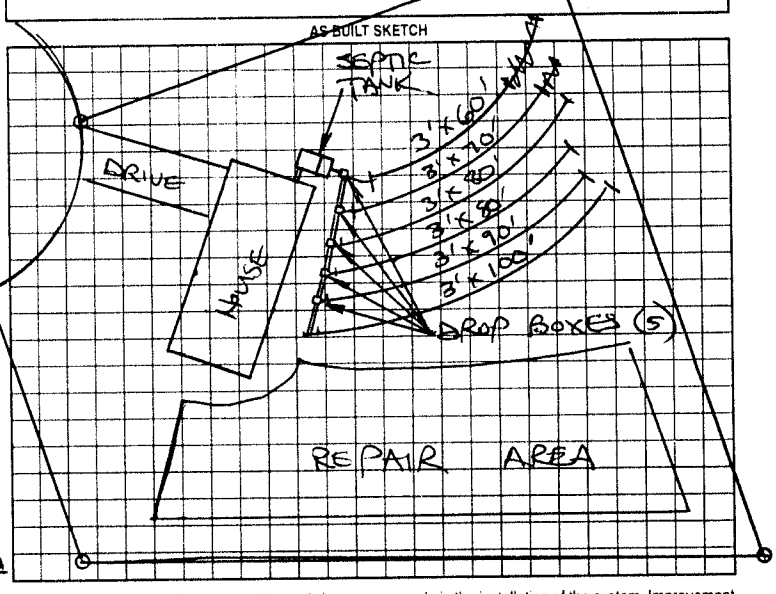

Permit can be suspended or revoked if any false information is supplied toward securing the permit/any unauthorized changes are made to the site/any unauthorized changes are made in the installation of the system. Improvement Permit with plat valid without expiration. Improvement Permit with site plan valid for sixty months. Authorization to Construct is valid for a period equal to that of Improvement Permit – not to exceed sixty months.

Signed: date 11-12-99 Installed by: A-1 BACKHOE

Improvement Permit by: date 10-30-99 Operation Permit by: STEVE HEDRICK date 5-17-00

Authorization to Construct by: STEVE HEDRICK date 3-7-00 Existing System Inspection by: date

HEALTH DEPT. COPY: WHITE OWNER COPY (FINAL): YELLOW OWNER COPY (INITIAL): PINK