IREDELL COUNTY HEALTH DEPARTMENT

STATESVILLE 704-878-5305 MOORESVILLE 704-664-5281

51417

IMPROVEMENT PERMIT / CERTIFICATE OF COMPLETION / OPERATION PERMIT / EXISTING SYSTEM INSPECTION

PROPERTY DESCRIPTION NO. 21959 DATE 8-30-95 TAX MAP NO. 9K-1-A-4 Watershed: ☐ Yes ☑ No

OWNER OR CONTRACTOR JAMES E. & SHIRLEY HITT, JR PHONE: Business Home 878-9664

ADDRESS 1216 RADIO ROAD, STATESVILLE, NC 28677

LOCATION NC 90 W, TR ANTIOCH RD, TR NEW AMITY, TL COLFAX 4TH LOT ON LEFT

SUBDIVISION OAK HILL BLOCK / SECTION LOT 4 LOT AREA 0.99 AC SITE CLASS PS DESIGN FLOW 540 L.T.A.R. 0.3 GPD/FT2

Septic Tank: 1000 Gallons; STB 797 Date 7-18-95

Pump Tank: Gallons; PT Date

Pump Make: Model Serial No.

Nitrification Field: No Fields 1 Square Feet 1800 Linear Feet 600

No Lines 4 Trench Width 36" Max Trench Bottom Depth 18-36" Gravel Depth 12"

☑ New System ☐ Repair System Type: I, II, III, IV, V, VI

System Description: CONVENTIONAL GRAVITY

Repair System Description: CONV. GRAVITY

Maintenance Agreement Required: ☐ Yes ☑ No

☐ Slab ☑ Crawl Space ☐ Basement w/plumbing ☐ Basement wo/plumbing

☐ House/Mod. Home No. Bedrooms 4

☑ Mobile Home No. Bathrooms 2

☐ Business 9 No. Employees


☐ Other 9 PERSONS

Water Supply: ☑ Individual ☐ Community ☐ Public BOTH AVAIL.

Comments: ① KEEP SYSTEM MINIMUM 100' FROM WELL 10' FROM PROPERTY LINE, 10' FROM WATER LINE 5' FROM MH, ② INSTALL LINES ON CONTOUR, NO BEEPER TRAN 36", 9' O.C.

Comments:

INITIAL SITE SKETCH

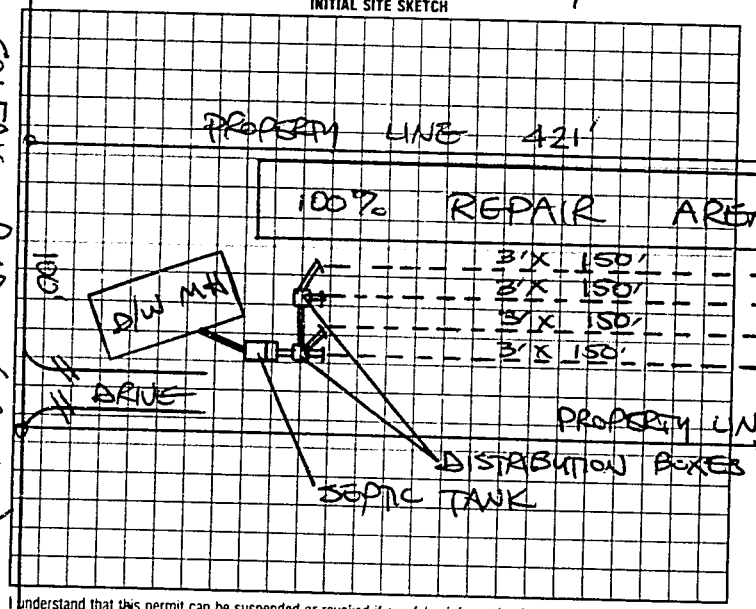

AS BUILT SKETCH

SYSTEM INSTALLED ACCORDING TO INITIAL SITE SKETCH

COLFAX ROAD (SR 1686)

I understand that this permit can be suspended or revoked if any false information is supplied toward securing the permit/any unauthorized changes are made to the site/any unauthorized changes are made in the installation of the system.

Signed: X James E. Hitt, Jr.

Improvement Permit by: STEVE HEARICK date 8-31-95

Existing System Inspection by: date

Installed by: A-1 BACKHOE

Certificate of Completion by: STEVE HEARICK date 9-8-95

Operation Permit by: date

HEALTH DEPT COPY WHITE INSPECTION COPY (FINAL) GREEN OWNER COPY (FINAL) YELLOW INSPECTION COPY (INITIAL) PINK OWNER COPY (INITIAL) GOLD

2 2 9 0 0 0