IREDELL COUNTY HEALTH DEPARTMENT

STATESVILLE 704-878-5305 MOORESVILLE 704-664-5281

IMPROVEMENT PERMIT / AUTHORIZATION TO CONSTRUCT / OPERATION PERMIT / EXISTING SYSTEM INSPECTION

PERMIT# 083349 PIN# 4706672037 (pt) DATE October 25, 99

OWNER OR CONTRACTOR Crandall & O'Brien Const PHONE: Business 871-1536 Home

ADDRESS 316 Treeback Rd. Statesville

LOCATION 90 WEST TR Scotts Creek RD X RR immediately TL New Amity TR WESTSCOTT ON Rt

SUBDIVISION WESTSCOTT BLOCK / SECTION LOT 7 LOT AREA .765 Ac SITE CLASS PS DESIGN FLOW 360 gpd L.T.A.R. .03

Septic Tank: 1000 Gallons; STB 1012 Date 3-11-00
Pump Tank: Gallons; PT Date
Pump Make: Model Serial No.
Nitrification Field: No Fields 1 Square Feet 1200 Linear Feet 400
No Lines 3 Trench Width 36" Max Trench Bottom Depth 36"

☑ New System ☐ Repair System Type: I II III IV V VI
System Description: GRAVITY CONVENTIONAL
Repair System Description: GRAVITY/PUMPED INNOVATIVE
Maintenance Agreement Required: Yes ☑ No 25% Red
Gravel Depth 12"

☑ House/Mod. Home No. Bedrooms 3
☐ Mobile Home No. Bathrooms 2
☐ Business No. Employees
☐ Other
☐ Slab ☑ Crawl Space ☐ Basement w/plumbing ☐ Basement wo/plumbing


Water Supply: ☐ Individual ☐ Public ☐ Community

Comments/Conditions: REMOVE old BARNS / TERRACES!
☒ optional tank location - will Require more Sch 40 pipe

Comments/Conditions: SEPTIC TANK W/ RISERS INSTALLED USING "POLYLOK" FILTER

1" ≈ 50'

INITIAL SITE SKETCH

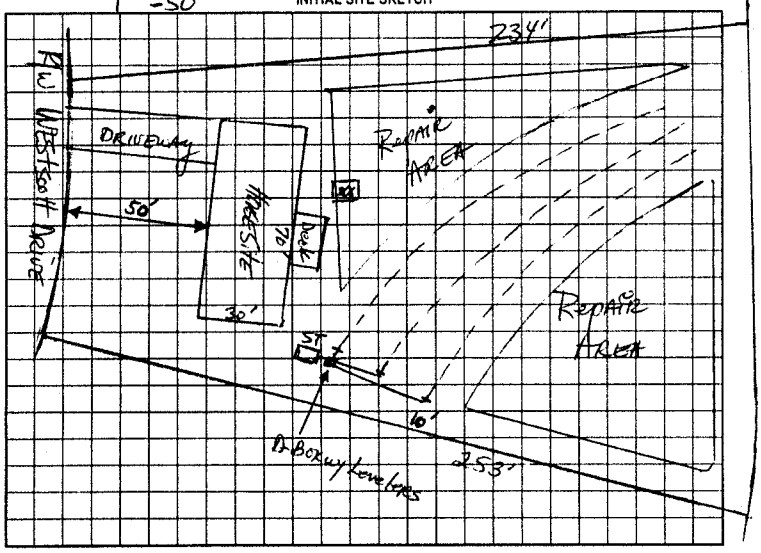

AS BUILT SKETCH

SYSTEM INSTALLED ACCORDING TO INITIAL SITE SKETCH

Permit can be suspended or revoked if any false information is supplied toward securing the permit/any unauthorized changes are made to the site/any unauthorized changes are made in the installation of the system. Improvement Permit with plat valid without expiration. Improvement Permit with site plan valid for sixty months. Authorization to Construct is valid for a period equal to that of Improvement Permit – not to exceed sixty months.

Signed: date 11-10-99 Installed by: A-1 BACK HOE

Improvement Permit by: date 10-25-99 Operation Permit by: STEVE HEDRICK date 7-26-00

Authorization to Construct by: STEVE HEDRICK date 3-1-00 Existing System Inspection by: date

HEALTH DEPT COPY WHITE OWNER COPY (FINAL) YELLOW OWNER COPY (INITIAL) PINK