IREDELL COUNTY HEALTH DEPARTMENT

STATESVILLE 704-878-5305 MOORESVILLE 704-664-5281

IMPROVEMENT PERMIT / AUTHORIZATION TO CONSTRUCT / OPERATION PERMIT / EXISTING SYSTEM INSPECTION

PERMIT# 083350 PIN# 4706672037 (pt.) DATE October 26, '99

OWNER OR CONTRACTOR Campbell & O'Briant Const. PHONE: Business 871-1536 Home

ADDRESS 310 Tree Bark Rd. Statesville

LOCATION 90 West TR Scotts Creek Rd x RR immediately TL New Quinty Rd TR Westscott Dr. on left

SUBDIVISION Westscott BLOCK / SECTION LOT 8 LOT AREA .75 Ac SITE CLASS PS DESIGN FLOW 360gpd L.T.A.R. 0.3

Septic Tank: 1000 Gallons; STB 1012 Date 9-24-00
Pump Tank: Gallons; PT Date
Pump Make: Model Serial No.
Nitrification Field: No Fields 1 Square Feet 1200 Linear Feet 400
No Lines 4@100' Trench Width 36" Max Trench Bottom Depth 36"

☒ New System ☐ Repair System Type: I, II, III, IV, V, VI
System Description: Gravity Conventional
Repair System Description: Same
Maintenance Agreement Required: ☐ Yes ☒ No

☒ House/Mod. Home No. Bedrooms 3
☐ Mobile Home No. Bathrooms 2
☐ Business No. Employees
☐ Other


☐ Slab ☒ Crawl Space ☐ Basement w/plumbing ☒ Basement wo/plumbing

Water Supply: ☐ Individual ☒ Public ☐ Community


Comments/Conditions: Remove old burms/terraces. Drop boxes may be used. 9-25-00 Talked w/ builder - buyer wants basement without plumbing - Basement floor level to start at existing grade at rear of house. ~50'

Comments/Conditions: Rec'd - 9-25-00 - Polylok filter installed Tank risers used

INITIAL SITE SKETCH

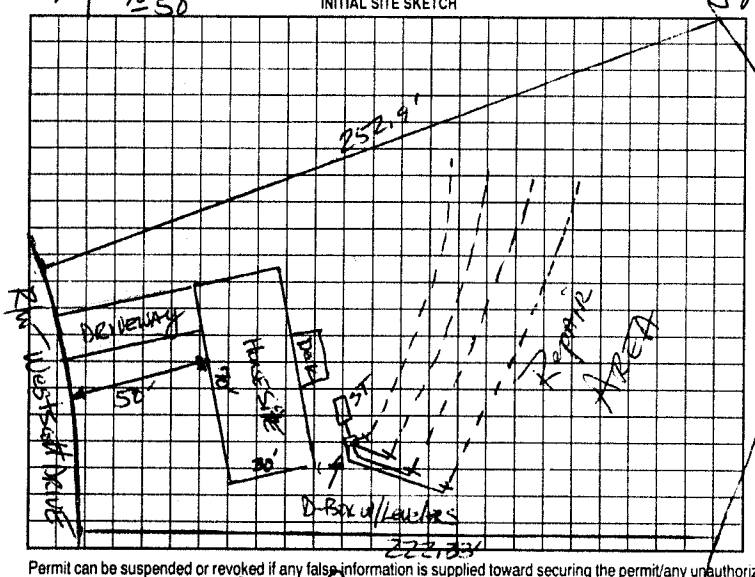

AS BUILT SKETCH

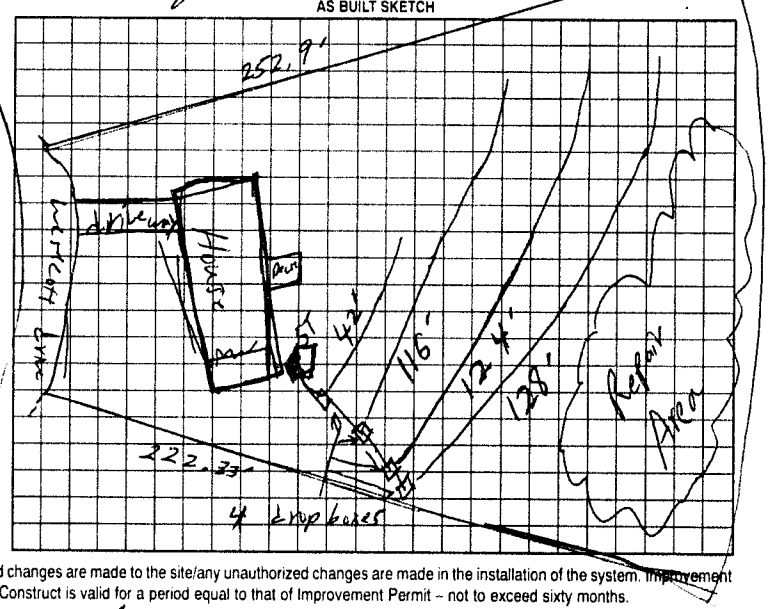

Permit can be suspended or revoked if any false information is supplied toward securing the permit/any unauthorized changes are made to the site/any unauthorized changes are made in the installation of the system. Improvement Permit with plat valid without expiration. Improvement Permit with site plan valid for sixty months. Authorization to Construct is valid for a period equal to that of Improvement Permit – not to exceed sixty months.

Signed: date 11-10-99 Installed by: A-1 Backhoe

Improvement Permit by: , RS date 10-26-99 Operation Permit by: William O Johnson RSI date 10-01

Authorization to Construct by: date 9-25-00 Existing System Inspection by: date

HEALTH DEPT COPY: WHITE OWNER COPY (FINAL): YELLOW OWNER COPY (INITIAL): PINK