IREDELL COUNTY HEALTH DEPARTMENT

STATESVILLE 704-878-5305 MOORESVILLE 704-664-5281

IMPROVEMENT PERMIT / AUTHORIZATION TO CONSTRUCT / OPERATION PERMIT / EXISTING SYSTEM INSPECTION

PERMIT# 083351 PIN# 4706672037 (pt) DATE October 26, '99

OWNER OR CONTRACTOR Craigdell & O'Brien Const. PHONE: Business 871-1536 Home

ADDRESS 310 Treebark Rd. Statesville

LOCATION 90 West TR Scotts Creek Rd. X RR immediately TL New Amity Rd TR Westscott Dr. on left

SUBDIVISION Westscott BLOCK / SECTION LOT 9 LOT AREA .59 Ac SITE CLASS. PS DESIGN FLOW 360 gpd L.T.A.R. .3

Septic Tank: 1000 Gallons; STB 1012 Date 3-12-2001
Pump Tank: Gallons; PT Date
Pump Make: Model Serial No.
Nitrification Field: No Fields 1 Square Feet 1200 Linear Feet 400
No Lines 4@100' Trench Width 36" Max Trench Bottom Depth 36" Gravel Depth 12"

☑ New System ☐ Repair System Type: I, II, III-IV, V, VI
System Description: Gravity Conventional
Repair System Description: Same
Maintenance Agreement Required: ☐ Yes ☑ No
☐ Slab ☑ Crawl Space ☐ Basement w/plumbing ☐ Basement wo/plumbing

☑ House/Mod. Home No. Bedrooms 3
☐ Mobile Home No. Bathrooms 2
☐ Business No. Employees
☐ Other


Water Supply: ☐ Individual ☑ Public ☐ Community

Comments/Conditions: Remove old burnt Trees. OK to use single S. Box w/levelers

Comments/Conditions: - Pig Tek Filter Installed - Septic Tank Marker Installed

1" = 50'

INITIAL SITE SKETCH

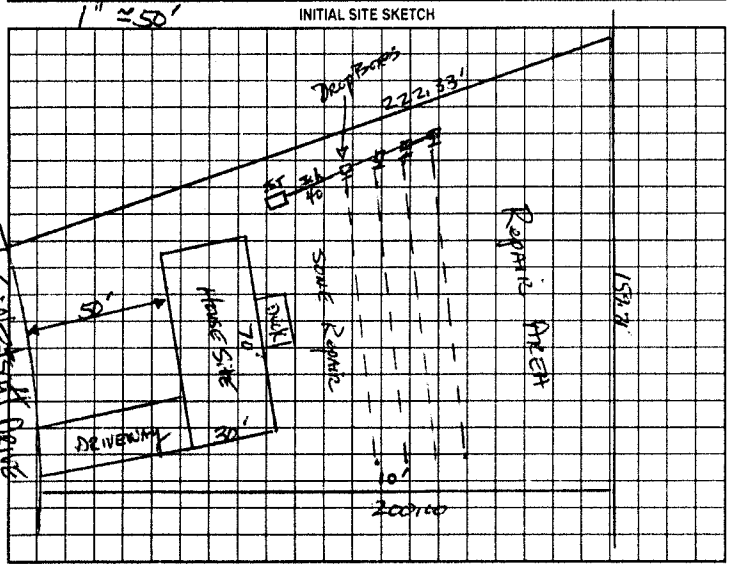

AS BUILT SKETCH

Installed as per Initial Site Sketch

Permit can be suspended or revoked if any false information is supplied toward securing the permit/any unauthorized changes are made to the site/any unauthorized changes are made in the installation of the system. Improvement Permit with plat valid without expiration. Improvement Permit with site plan valid for sixty months. Authorization to Construct is valid for a period equal to that of Improvement Permit – not to exceed sixty months.

Signed: date 11-10-99 Installed by: A-1 Back hoe

Improvement Permit by: date 10-26-99 Operation Permit by: William O. Johnson date 5-18-01

Authorization to Construct by: STEVE HEDRICK date 3-14-01 Existing System Inspection by: date

HEALTH DEPT. COPY WHITE OWNER COPY (FINAL) YELLOW OWNER COPY (INITIAL) PINK