originally installed 6/30/89

49096

IREDELL COUNTY HEALTH DEPARTMENT

STATESVILLE 704-878-5305 MOORESVILLE 704-664-5281

IMPROVEMENT PERMIT / CERTIFICATE OF COMPLETION / OPERATION PERMIT / EXISTING SYSTEM INSPECTION

PROPERTY DESCRIPTION NO. 17186 DATE 10/15/93 TAX MAP NO. 9K-A-57

OWNER OR CONTRACTOR SAM FROGGE PHONE: Business Home 585-9513

ADDRESS RT. 8, BOX 122, STV NC 28677

LOCATION NC 90 W, TR ANTIETAM ROAD, TR PRIVATE DRIVE ~ 0.5 MILE, OFF ROAD ~ 330'

SUBDIVISION BLOCK / SECTION LOT LOT AREA 350 X 810 SITE CLASS. RS L.T.A.R. EXISTING 0.33

Water Supply: ☑ Individual ☐ Community ☐ Public WELL

Septic Tank: EXISTING Gallons; STB Date

Pump Tank: Gallons; PT Date

Nitrification Field: No Fields 1 Square Feet 360 Linear Feet 120'

No Lines 1 Trench Width 36" Trench Depth 18-36 Gravel Depth 12"

☐ New System ☐ Repair System Type: I, II, III, IV, V, VI

System Description: CONV. GRAVITY

Repair System Description: CONV. GRAVITY

Maintenance Agreement Required: ☐ Yes ☐ No

☐ House/Mod. Home ☑ Mobile Home ☐ Business ☐ Other

No. Bedrooms 3 No. Bathrooms 2½ No. Employees

Garbage Disposal: ☐ Yes ☑ No

Auto. Dishwasher: ☑ Yes ☐ No


Auto. Washing Machine: ☑ Yes ☐ No

Other

☐ Slab ☑ Crawl Space ☐ Basement w/plumbing ☐ Basement wo/plumbing

Comments (1) KEEP SYSTEM MINIMUM 5' FROM MH 10' FROM PROPANE LINE, 30' FROM WELL (2) INSTALL NEW NITRIFICATION LINE AS SHOWN, ON CONTOUR NO DEEPER THAN 36", 9' APART FROM EXISTING LINES

INITIAL SITE SKETCH

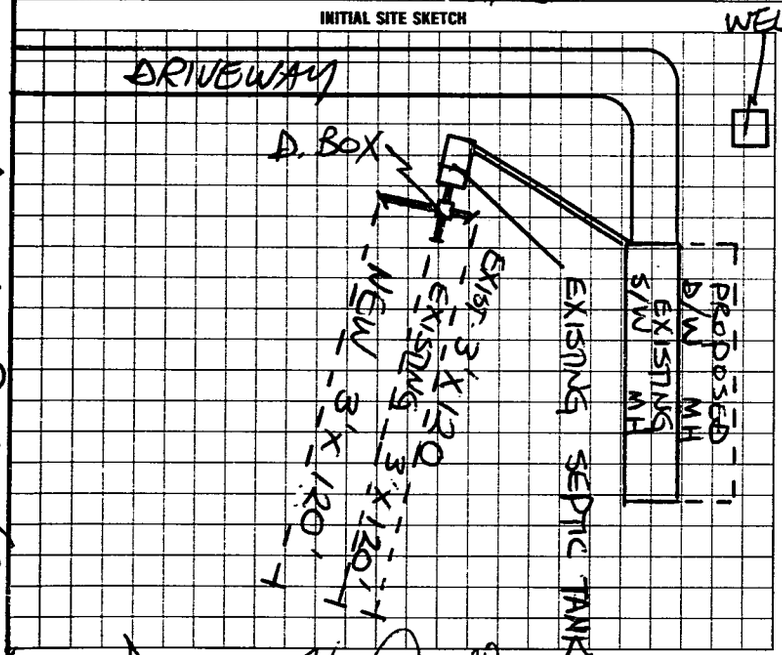

AS BUILT SKETCH

ADDITIONAL 3'X120' NITRIFICATION LINE INSTALLED ACCORDING TO INITIAL SITE SKETCH.

I understand that this permit can be suspended or revoked if any false information is supplied toward securing the permit/any unauthorized changes are made to the site/any unauthorized changes are made in the installation of the system. Improvement Permit is valid for 60 months from date of issuance.

Signed: X

Improvement Permit by: STEVE HEDRICK date 10/15/93

Installed by: DONALD LACKEY

Certificate of Completion by: STEVE HEDRICK date 10/21/93

Existing System Inspection by: date

Operation Permit by: date

HEALTH DEPT. COPY: WHITE INSPECTION COPY (FINAL): GREEN OWNER COPY (FINAL): YELLOW INSPECTION COPY (INITIAL): PINK OWNER COPY (INITIAL): GOLD