IREDELL COUNTY HEALTH DEPARTMENT

STATESVILLE 704-878-5305 MOORESVILLE 704-664-5281

58834 9:00 David Yount

IMPROVEMENT PERMIT / CERTIFICATE OF COMPLETION / OPERATION PERMIT / EXISTING SYSTEM INSPECTION

PROPERTY DESCRIPTION NO. 22896 DATE 1-2-96 TAX MAP NO. 9F-2-A-30 Watershed: ☐ Yes ☑ No

OWNER OR CONTRACTOR TODD ELLIS PHONE: Business 878-8169-C-15 Home 878-6633

ADDRESS 178 MEADOW OAKS DRIVE, STATESVILLE, NC 28677

LOCATION NC 90W, TR SCOTTS CREEK ROAD, TR LARKIN LANE, TL TROJAN ROAD, 2ND LOT ON RIGHT

SUBDIVISION SCOTTS CREEK BLOCK / SECTION ____ LOT 30 LOT AREA 1.044 AC SITE CLASS PS DESIGN FLOW 360 L.T.A.R. 0.50 GPD/FT²

Septic Tank: 1000 Gallons; STB 1012 TF Date 4/21/96

Pump Tank: ____ Gallons; PT ____ Date ____

Pump Make: ____ Model ____ Serial No. ____

Nitrification Field: No Fields 1 Square Feet 1200 Linear Feet 400

No Lines 4 Trench Width 36" Max Trench Bottom Depth 18-36" Gravel Depth 12"

☑ New System ☐ Repair System Type: I, II, III, IV, V, VI

System Description: CONVENTIONAL GRAVITY

Repair System Description: CONVENTIONAL GRAVITY

Maintenance Agreement Required: ☐ Yes ☑ No

☑ House/Mod. Home No. Bedrooms 3

☐ Mobile Home No. Bathrooms 2

☐ Business No. Employees ____

☐ Other ____


☐ Slab ☑ Crawl Space ☐ Basement w/plumbing ☐ Basement wo/plumbing

Water Supply: ☐ Individual ☐ Community ☑ Public


Comments:

Comments:

INITIAL SITE SKETCH

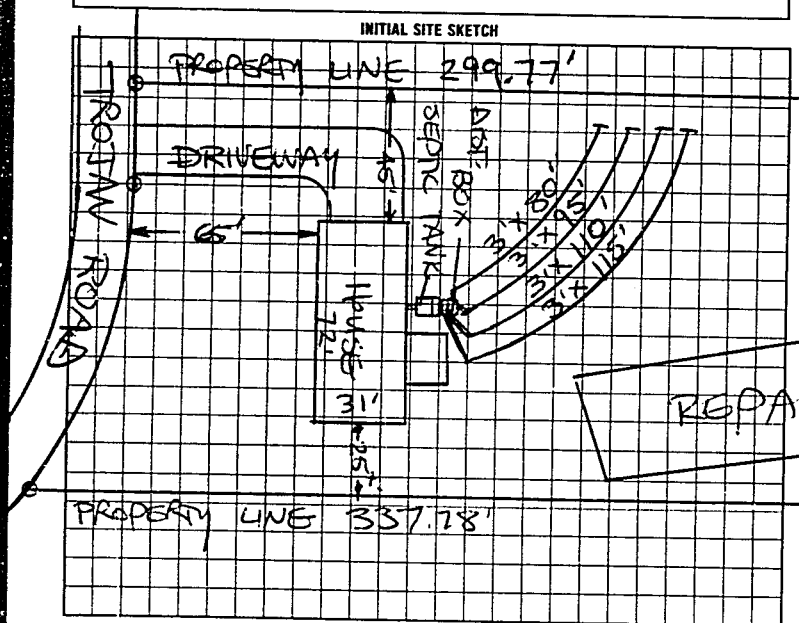

AS BUILT SKETCH

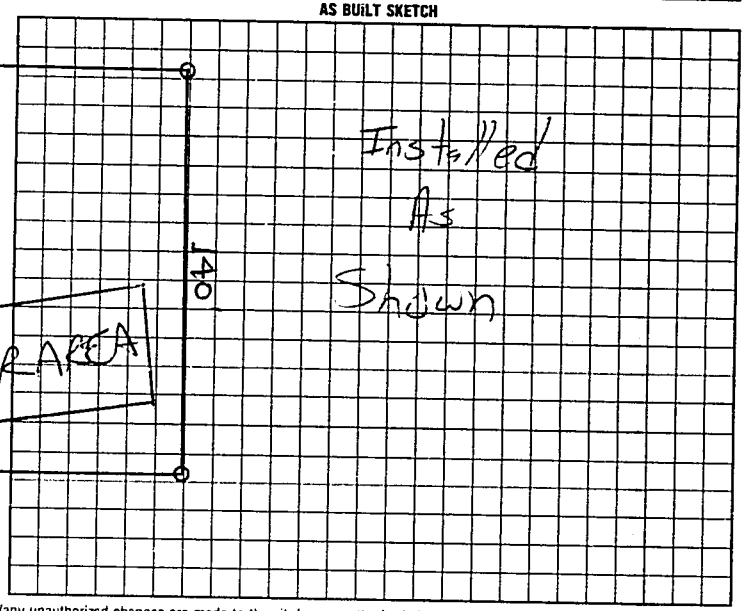

I understand that this permit can be suspended or revoked if any false information is supplied toward securing the permit/any unauthorized changes are made to the site/any unauthorized changes are made in the installation of the system.

AUTHORIZATION TO CONSTRUCT IS VALID FIVE (5) YEARS FROM DATE OF ISSUANCE. IMPROVEMENT PERMIT HAS NO EXPIRATION DATE.

Signed: X

Improvement Permit by: STEVE HENDRICK date 1-2-96

AUTHORIZATION TO CONSTRUCT STEVE HENDRICK

~~Existing System Inspection by:~~ ____ date ____

Installed by: David Yount

~~Certificate of Completion by:~~ ____ date ____

Operation Permit by: [signature] date 7/2/96

HEALTH DEPT. COPY. WHITE INSPECTION COPY (FINAL) GREEN OWNER COPY (FINAL) YELLOW INSPECTION COPY (INITIAL) PINK OWNER COPY (INITIAL) GOLD