62330

IREDELL COUNTY HEALTH DEPARTMENT

STATESVILLE 704-878-5305 MOORESVILLE 704-664-5281

IMPROVEMENT PERMIT / CERTIFICATE OF COMPLETION / OPERATION PERMIT / EXISTING SYSTEM INSPECTION

PROPERTY DESCRIPTION NO. 23723 DATE 5-18-96 TAX MAP NO. 9F-2-A-22 Watershed: ☐ Yes ☒ No

OWNER OR CONTRACTOR TODD ELLIS PHONE: Business Home 878-6633

ADDRESS 178 MEADOW OAKS DR STATESVILLE NC 28677

LOCATION NC 90 W TR SCOTTS CREEK RD TR KARIN LANE TL TROJAN LANE 1ST LOT ON LEFT

SUBDIVISION SCOTTS CREEK BLOCK / SECTION LOT 22 LOT AREA ~160'X270' SITE CLASS. PS DESIGN FLOW 360 L.T.A.R. 0.33 GPD/FT2

Septic Tank: 1000 Gallons; STB 1012 Date 8-9-96

Pump Tank: Gallons; PT Date

Pump Make: Model Serial No.

Nitrification Field: No Fields I Square Feet 1080 Linear Feet 360

No Lines 3 Trench Width 36" Max Trench Bottom Depth 18-36" Gravel Depth 12"

☐ New System ☐ Repair System Type: ☒ I, II, III, IV, V, VI

System Description: CONV. GRAVITY

Repair System Description: CONV. GRAVITY

Maintenance Agreement Required: ☐ Yes ☒ No

☒ House/Mod. Home No. Bedrooms 3

☐ Mobile Home No. Bathrooms 2

☐ Business No. Employees

☐ Other


☐ Slab ☒ Crawl Space ☐ Basement w/plumbing ☐ Basement wo/plumbing

Water Supply: ☐ Individual ☐ Community ☒ Public


Comments:

Comments:

INITIAL SITE SKETCH

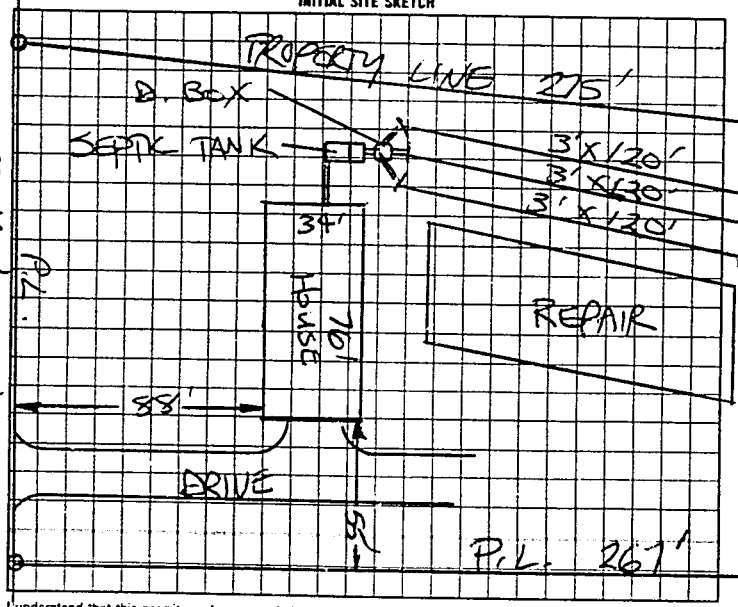

AS BUILT SKETCH

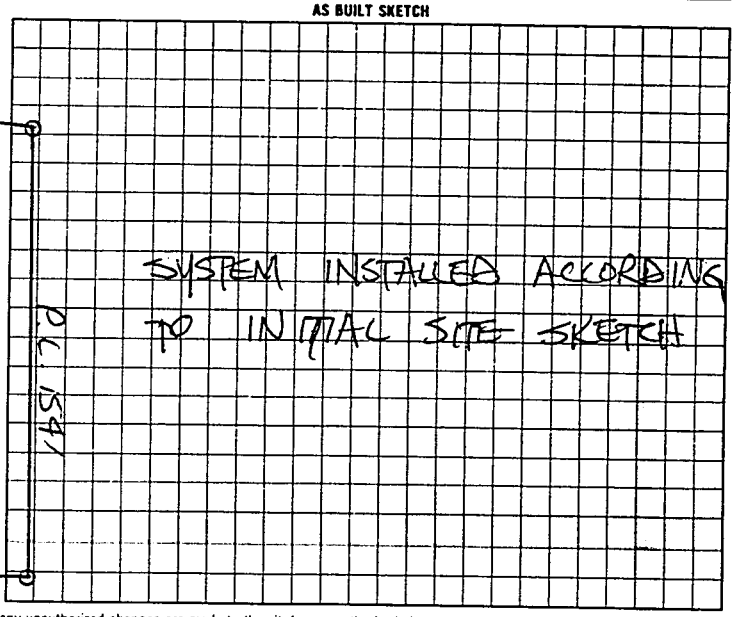

I understand that this permit can be suspended or revoked if any false information is supplied toward securing the permit/any unauthorized changes are made to the site/any unauthorized changes are made in the installation of the system.

Authorization to Construct is valid five (5) years from date of issuance. Improvement Permit has no expiration date.

Signed: X

Improvement Permit by: STEVE HEDRICK date 5-18-96

Installed by: DAVID YOUNTZ

Certificate of Completion by: date

AUTHORIZATION TO CONSTRUCT: STEVE HEDRICK date 5-18-96

Operation Permit by: STEVE HEDRICK date 11-20-96

HEALTH DEPT. COPY: WHITE INSPECTION COPY (FINAL): GREEN OWNER COPY (FINAL): YELLOW INSPECTION COPY (INITIAL): PINK OWNER COPY (INITIAL): GOLD