TODD ELLIS

THIS PERMIT VOIDS PREVIOUS ISSUED 5/11/95 (21000) 58835

IREDELL COUNTY HEALTH DEPARTMENT

STATESVILLE 704-878-5305 MOORESVILLE 704-664-5281

IMPROVEMENT PERMIT / CERTIFICATE OF COMPLETION / OPERATION PERMIT / EXISTING SYSTEM INSPECTION

PROPERTY DESCRIPTION NO. 21000 DATE 1-2-96 TAX MAP NO 9E-2-A-28 Watershed: ☐ Yes ☑ No

OWNER OR CONTRACTOR ARCHIE PIERCE PHONE: Business 878-3169, C-15 Home 878-6633

ADDRESS NC 90 W, TR SCOTTS CREEK RD, TR LARKIN LANE TL TROJAN ROAD 4TH LOT ON RIGHT

LOCATION 178 MEADOW OAKS DRIVE, STATESVILLE, NC 28677

SUBDIVISION SCOTTS CREEK BLOCK / SECTION ____ LOT 28 LOT AREA 1.044 AC SITE CLASS. PS DESIGN FLOW 360 L.T.A.R. 0.30 GPD/FT²

Septic Tank: 1000 Gallons; STB 1012 Date 5-11-96

Pump Tank: ____ Gallons; PT ____ Date ____

Pump Make: ____ Model ____ Serial No. ____

Nitrification Field: No Fields 1 Square Feet 1200 Linear Feet 400

No Lines 3 Trench Width 36" Max Trench Bottom Depth 18"-36" Gravel Depth 12"

☑ New System ☐ Repair System Type: I ☑ II, III, IV, V, VI

System Description: CONVENTIONAL GRAVITY

Repair System Description: CONV. GRAVITY

Maintenance Agreement Required: ☐ Yes ☑ No

☑ House/Mod. Home No. Bedrooms 3

☐ Mobile Home No. Bathrooms 2

☐ Business No. Employees ____

☐ Other ____


☐ Slab ☑ Crawl Space ☐ Basement w/plumbing ☐ Basement wo/plumbing

Water Supply:
☐ Individual
☐ Community
☑ Public


Comments:

Comments:

INITIAL SITE SKETCH

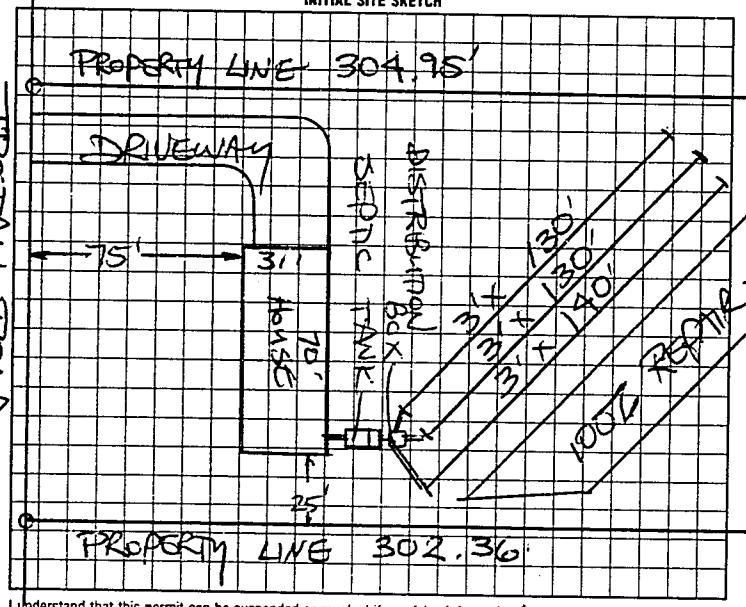

AS BUILT SKETCH

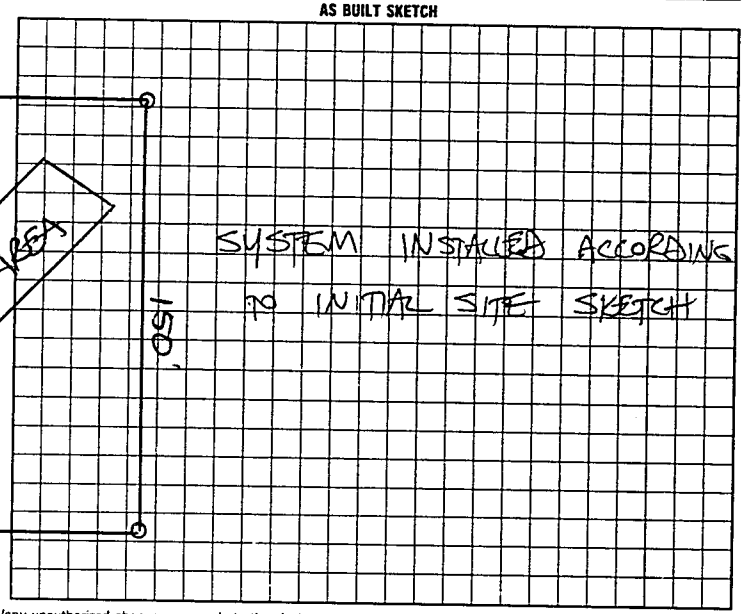

I understand that this permit can be suspended or revoked if any false information is supplied toward securing the permit/any unauthorized changes are made to the site/any unauthorized changes are made in the installation of the system.

AUTHORIZATION TO CONSTRUCT IS VALID FIVE (5) YEARS FROM DATE OF ISSUANCE. IMPROVEMENT PERMIT HAS NO EXPIRATION DATE.

Signed: Todd Ellis

Improvement Permit by: STEVE HEDRICK date 1-2-96

~~Existing System Inspection~~ AUTHORIZATION TO CONSTRUCT by: STEVE HEDRICK date 1-2-95

Installed by: DAVID YOUNTZ

~~Certificate of Completion~~ by: ____ date ____

Operation Permit by: STEVE HEDRICK date 8-1-96

HEALTH DEPT. COPY: WHITE INSPECTION COPY (FINAL): GREEN OWNER COPY (FINAL): YELLOW INSPECTION COPY (INITIAL): PINK OWNER COPY (INITIAL): GOLD