IREDELL COUNTY HEALTH DEPARTMENT

STATESVILLE 704-878-5305 MOORESVILLE 704-664-5281

IMPROVEMENT PERMIT / CERTIFICATE OF COMPLETION / OPERATION PERMIT / EXISTING SYSTEM INSPECTION

PROPERTY DESCRIPTION NO. 23724 DATE 5-18-96 TAX MAP NO. 9F-2-A-23 Watershed: ☐ Yes ☒ No

OWNER OR CONTRACTOR J. TODD ELLIS PHONE: Business Home 878-6633

ADDRESS 178 MEADOW OAKS DRIVE, STATESVILLE, NC 28677

LOCATION NC 90 W. TR SCOTTS CREEK RD, TR LARKIN LANE, TL TROJAN LANE 2ND ON LEFT

SUBDIVISION SCOTTS CREEK BLOCK / SECTION LOT 23 LOT AREA ~180' X 260' SITE CLASS PS DESIGN FLOW 360 L.T.A.R. 0.38 GPD/FT2

Septic Tank: 1000 Gallons; STB 1012 Date 5-24-97

Pump Tank: Gallons; PT Date

Pump Make: Model Serial No.

Nitrification Field: No Fields Square Feet 1080 Linear Feet 360

No Lines 3 Trench Width 36" Max Trench Bottom Depth 18-36" Gravel Depth 12"

☑ New System ☐ Repair System Type: I, II, III, IV, V, VI

System Description: CONVENTIONAL GRAV

Repair System Description: CONV. GRAV.

Maintenance Agreement Required: ☐ Yes ☒ No

☒ House/Mod. Home ☐ Mobile Home ☐ Business ☐ Other

No. Bedrooms 3 No. Bathrooms 2 No. Employees


☐ Slab ☒ Crawl Space ☐ Basement w/plumbing ☐ Basement wo/plumbing

Water Supply: ☐ Individual ☐ Community ☒ Public


Comments:

Comments:

INITIAL SITE SKETCH

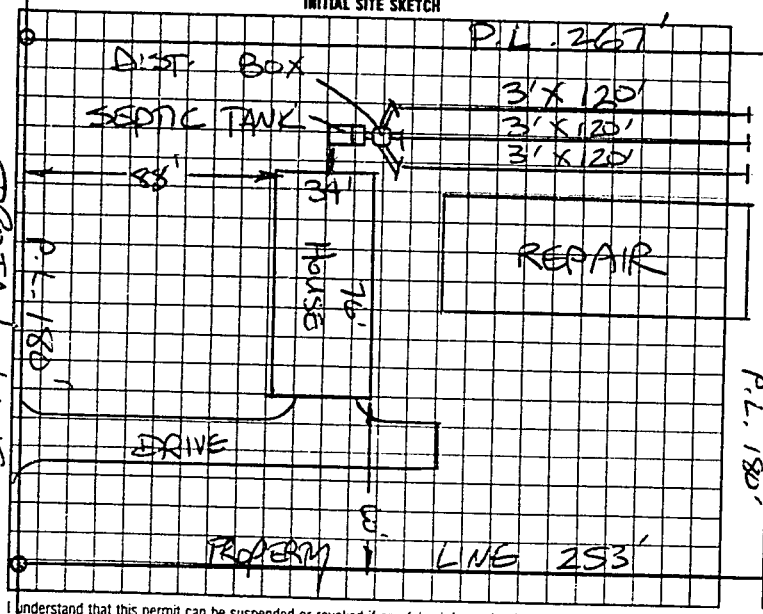

AS BUILT SKETCH

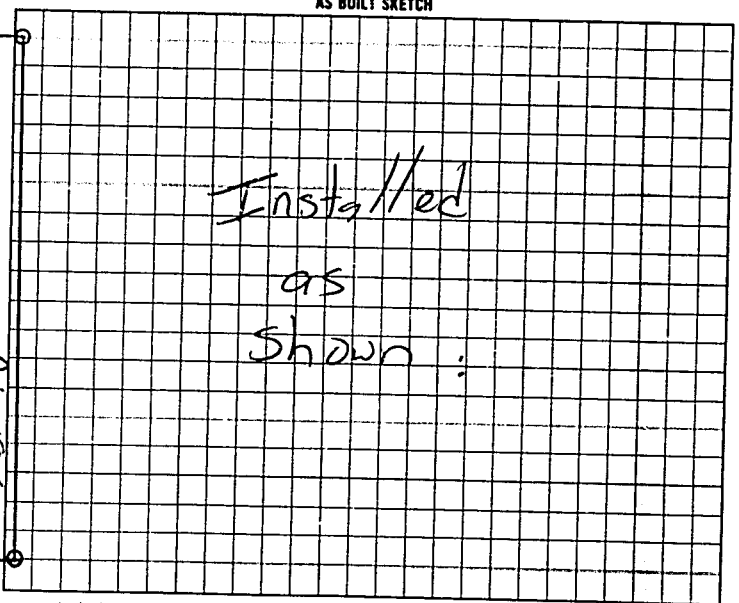

I understand that this permit can be suspended or revoked if any false information is supplied toward securing the permit/any unauthorized changes are made to the site/any unauthorized changes are made in the installation of the system.

Authorization to Construct is valid five (5) years from date of issuance. Improvement Permit has no expiration date.

Signed

Improvement Permit by STEVE HEDRICK date 5-18-96 Installed by David Hunt

AUTHORIZATION TO CONSTRUCT: Evaluation/Inspection by STEVE HEDRICK date 5-18-96 Certificate of Completion by date

Operation Permit by Mark C. Outlaw date 5-2-97

HEALTH DEPT COPY WHITE INSPECTION COPY (FINAL) GREEN OWNER COPY (FINAL) YELLOW INSPECTION COPY (INITIAL) PINK OWNER COPY (INITIAL) GOLD