IREDELL COUNTY HEALTH DEPARTMENT

STATESVILLE 704-878-5305 — MOORESVILLE 704-664-5281

62441

IMPROVEMENT PERMIT / CERTIFICATE OF COMPLETION / OPERATION PERMIT / EXISTING SYSTEM INSPECTION

PROPERTY DESCRIPTION NO. 23607 DATE 4-29-96 TAX MAP NO. 9F-2-A-27 Watershed: ☐ Yes ☒ No

OWNER OR CONTRACTOR K. W. NICHOLSON, INC PHONE: Business 838-9724 Home 876-4359

ADDRESS 182 MILLSTONE DRIVE, STATESVILLE, NC 28677

LOCATION N.C 90 W, TR SCOTTS CREEK RD,

SUBDIVISION SCOTTS CREEK ES BLOCK / SECTION ____ LOT 27 LOT AREA ~150'X300' SITE CLASS. RS DESIGN FLOW 360 L.T.A.R. 0.306 GPD/FT2

Septic Tank: 1000 Gallons; STB 1012 Date 7-21-96

Pump Tank: ____ Gallons; PT ____ Date ____

Pump Make: ____ Model ____ Serial No. ____

Nitrification Field: No Fields 1 Square Feet 1200 Linear Feet 400

No Lines 4 Trench Width 36" Max Trench Bottom Depth 36" Gravel Depth 12"

☒ New System ☐ Repair System Type: I, II, III, IV, V, VI

System Description: CONVENTIONAL GRAVITY

Repair System Description: CONV. GRAVITY

Maintenance Agreement Required: ☐ Yes ☒ No

☒ House/Mod. Home No. Bedrooms 3

☐ Mobile Home No. Bathrooms 2

☐ Business No. Employees ____

☐ Other ____


☐ Slab ☒ Crawl Space ☐ Basement w/plumbing ☐ Basement wo/plumbing

Water Supply: ☐ Individual ☐ Community ☒ Public


Comments:

Comments:

INITIAL SITE SKETCH

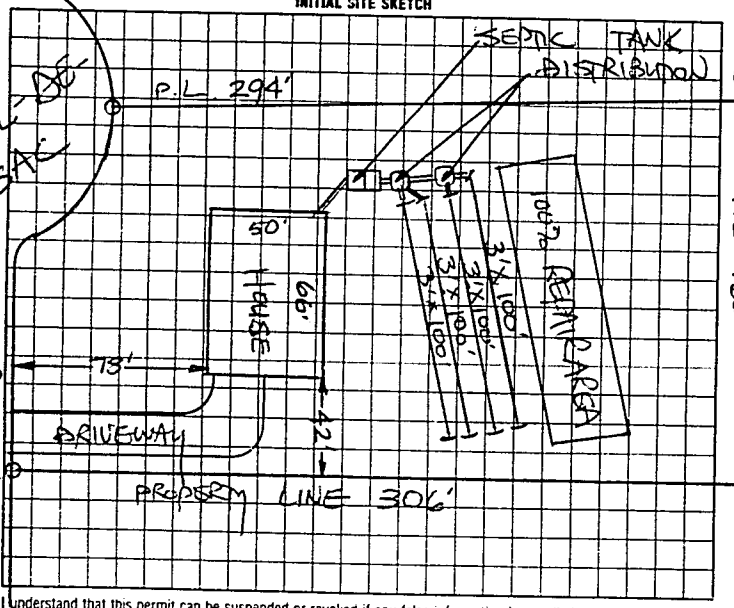

AS BUILT SKETCH

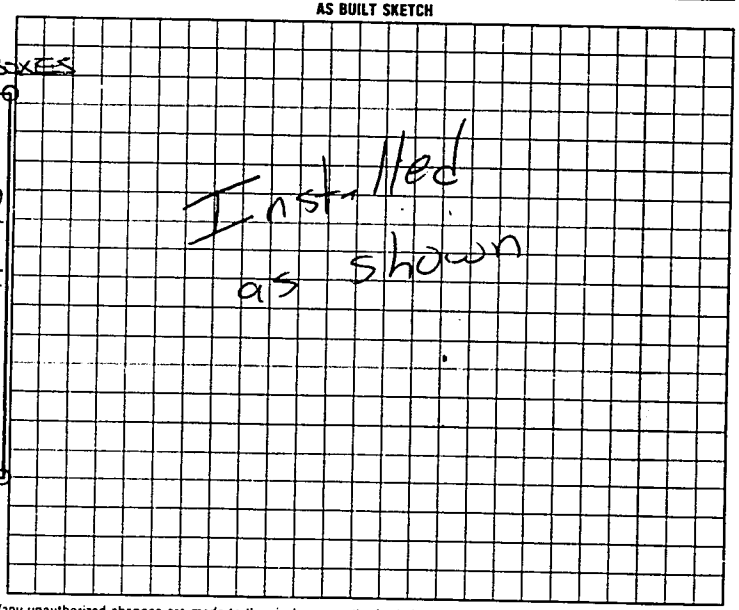

I understand that this permit can be suspended or revoked if any false information is supplied toward securing the permit/any unauthorized changes are made to the site/any unauthorized changes are made in the installation of the system.

Authorization to Construct is valid five (5) years from date of issuance. Improvement Permit has no expiration date.

Signed: X Kent W Nicholson

Improvement Permit by: STEVE HEARICK date 4-29-96

Existing System Inspection by: STEVE HEARICK date 4-29-96

AUTHORIZATION TO CONSTRUCT:

Installed by: Tommy Frye

Certificate of Completion by: ____ date ____

Operation Permit by: Mark Ort RS date 11-1-96

HEALTH DEPT COPY WHITE — INSPECTION COPY (FINAL) GREEN — OWNER COPY (FINAL) YELLOW — INSPECTION COPY (INITIAL) PINK — OWNER COPY (INITIAL) GOLD

599100