IREDELL COUNTY HEALTH DEPARTMENT

STATESVILLE 704-878-5305 MOORESVILLE 704-664-5281

IMPROVEMENT PERMIT / AUTHORIZATION TO CONSTRUCT / OPERATION PERMIT / EXISTING SYSTEM INSPECTION

PERMIT # 158805 PIN # 9706-74-4995 DATE 11-13-09

OWNER or APPLICANT James & Shelby Parker PHONE: Business Home: 704-902-9669

OWNER or APPLICANT ADDRESS 149 Parkinsley Statesville NC 28625

LOCATION / DIRECTIONS 115 N to Scots Creek (R) Parker in 149 Parker in Cul-de-sac

SUBDIVISION Scots Creek BLOCK / SECTION LOT # 24 LOT AREA .75 AC DESIGN FLOW 360 L.T.A.R. .3 (Prev)

Septic Tank 1000 Prev Gallons: STB 1000 (Add) Date 2-9-98 (Add)
Pump Tank Gallons: P T Date
Pump Make Model Serial #
Nitrification Field No Fields No Lines 4 Linear Feet 40'
Trench Width 36" Max. Trench Bottom Depth 36" Gravel Depth 12"

~~New System~~ Repair Expansion System Type I II III IV V VI
System Description: Conventional Gravity
Repair System Description: 50% Red Pump
Maintenance Agreement Required YES NO Repair
GRAVITY PRESSURE

Residence No. Bedrooms 3
Business No. Persons
Other No. Employees
Slab Crawl Space
Basement w/plumbing Basement w/o plumbing

Water Supply: Private, Public, Community

Comments / Conditions

Garage Built over repair area reduced repair to 50% Low Pres. unless pent yard can be used then pump to 25% reduction


Comments / Conditions

INITIAL SITE SKETCH

Maintain at least 5' from Septic tank

Keep 3' from Septic tank

AS BUILT SKETCH

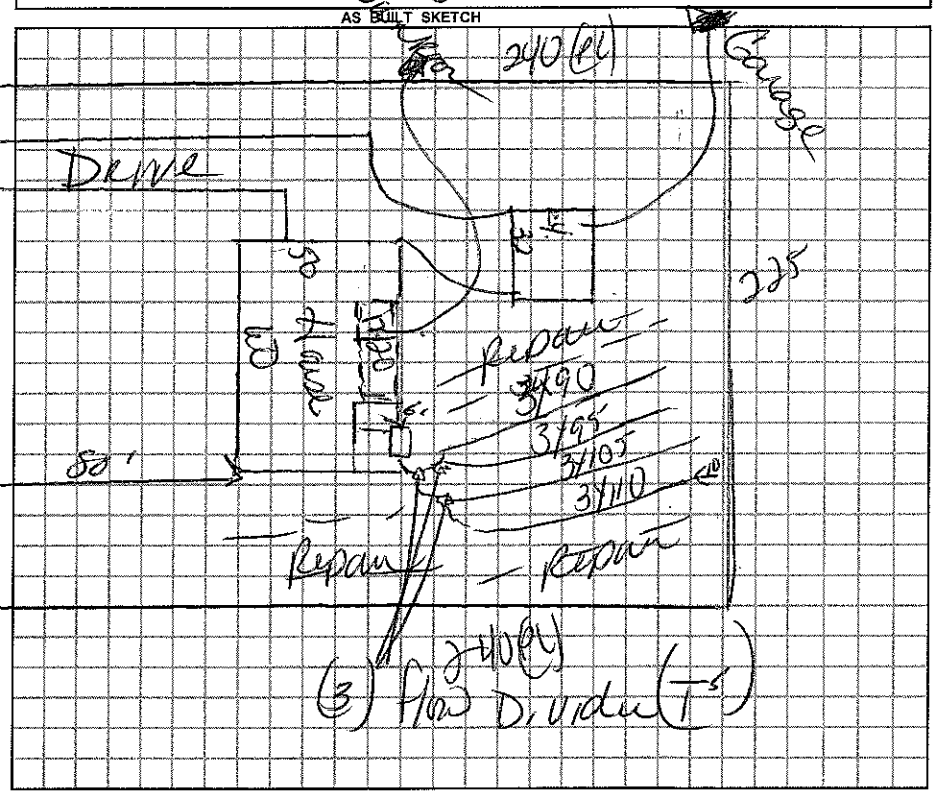

Permit can be suspended or revoked if any false information is supplied toward securing the permit / any unauthorized changes are made to the site / any unauthorized changes are made in the installation of the system.

☐ *IMPROVEMENT PERMIT w/ plat valid without expiration.* ☐ *IMPROVEMENT PERMIT w / site plan valid for 60 mos.* ☑ *AUTHORIZATION TO CONSTRUCT valid for period equal to IMPROVEMENT PERMIT-not to exceed 60 mo.*

Owner / Applicant Signature: James McAlpin Date 11/13/09

Improvement Permit by: Date

Authorization to Construct by: Date

YOU SHOULD CONTACT A LOCATOR SERVICE PRIOR TO ANY EXCAVATION.

Installed by:

Operation Permit by: Date:

Existing System Inspected by: Kelly Cook Date: 11-13-09

WHITE COPY Environmental Health YELLOW COPY (Final) Owner / Applicant PINK COPY (Initial) Owner / Applicant