IREDELL COUNTY HEALTH DEPARTMENT

STATESVILLE 704-878-5305 MOORESVILLE 704-664-5281

IMPROVEMENT PERMIT / CERTIFICATE OF COMPLETION / OPERATION PERMIT / EXISTING SYSTEM INSPECTION

PROPERTY DESCRIPTION NO. 24947 [illegible]69 DATE 9-18-96 TAX MAP NO. 9F-2-A-24 Watershed: ☐ Yes ☐ No

OWNER OR CONTRACTOR K. W. Nicholson Inc. PHONE: Business _____ Home 876 4359

ADDRESS 182 millstone Dr. statesville

LOCATION Hwy 90 TR Scotts Creek Rd TR Larkin Ln Nearest left.

SUBDIVISION Scotts Creek BLOCK / SECTION _____ LOT 24 LOT AREA 3/4 acre SITE CLASS. PS DESIGN FLOW 360 L.T.A.R. 1.3

Septic Tank: 1000 Gallons; STB 1017 Date ~~2-9-98~~ 2-9-98

Pump Tank: _____ Gallons; PT _____ Date _____

Pump Make: _____ Model _____ Serial No. _____

Nitrification Field: No Fields 1 Square Feet 1200 Linear Feet 400

No Lines 4 Trench Width 36" Max Trench Bottom Depth 36" Gravel Depth 12"

☑ New System ☐ Repair System Type: I, ☑ II, III, IV, V, VI

System Description: Conv. Gravity

Repair System Description: Pump To ~~Conventional~~ Chambers

Maintenance Agreement Required: ☐ Yes ☑ No

☑ House/Mod. Home No. Bedrooms 3

☐ Mobile Home No. Bathrooms 2

☐ Business No. Employees _____

☐ Other _____


☐ Slab ☑ Crawl Space ☐ Basement w/plumbing ☐ Basement wo/plumbing

Water Supply: ☐ Individual ☐ Community ☑ Public


Comments:

Comments: Note lines all 100ft back still ~15ft from property line

INITIAL SITE SKETCH

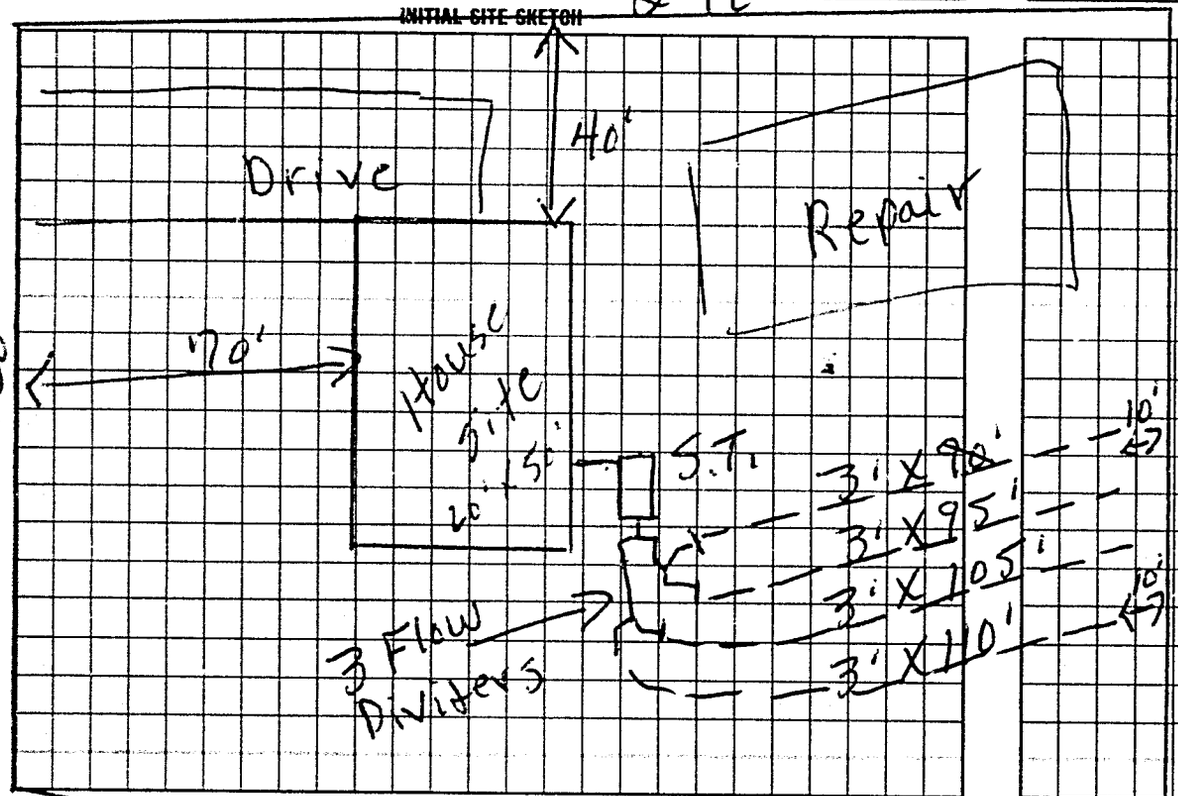

AS BUILT SKETCH

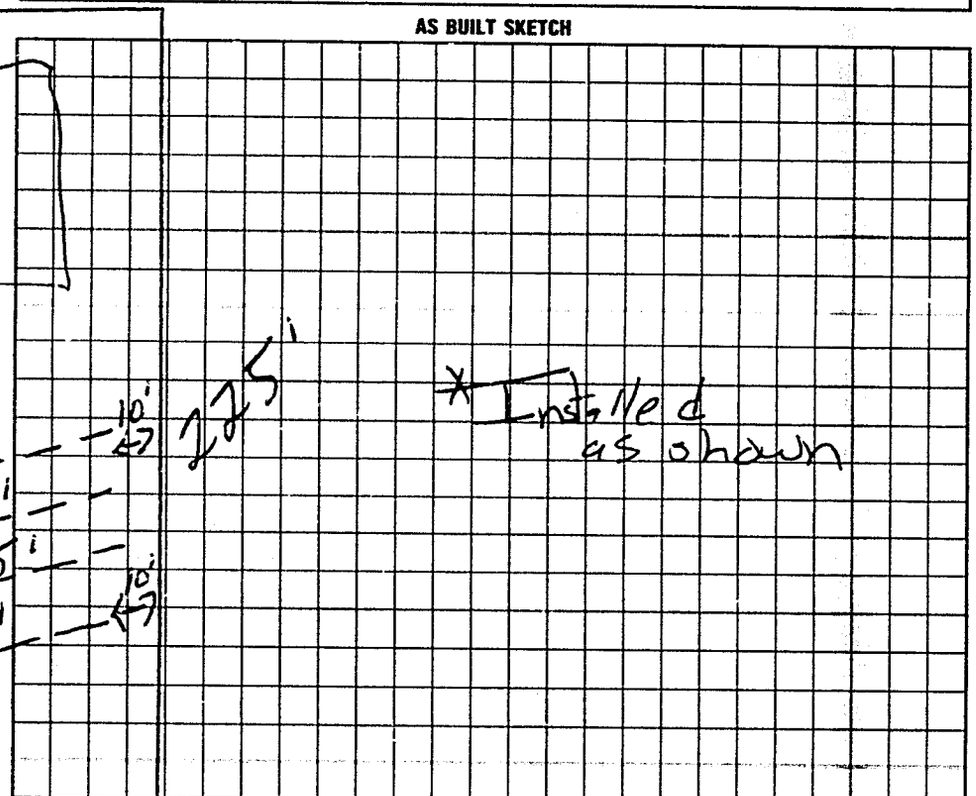

I understand that this permit can be suspended or revoked if any false information is supplied toward securing the permit/any unauthorized changes are made to the site/any unauthorized changes are made in the installation of the system.

Signed: X K W Nicholson Inc 240'

Improvement Permit by: P.C. Moore date _____

Authorization to Construct by: P.C. Moore date _____

Existing System Inspection by: _____ date _____

Installed by: David Yountz

Certificate of Completion by: _____ date _____

Operation Permit by: Mark C Ort RS date 4-16-98

Authorization to construct expires two years from issue

APPLICANT'S RECEIPT COPY WITH INSPECTION COPY (FINAL) GREEN OWNER COPY (FINAL) - YELLOW INSPECTION COPY (INITIAL) PINK OWNER COPY (INITIAL) GOLD