IREDELL COUNTY HEALTH DEPARTMENT

STATESVILLE 704-878-5305 (CI) MOORESVILLE 704-664-5281

IMPROVEMENT PERMIT / AUTHORIZATION TO CONSTRUCT / OPERATION PERMIT / EXISTING SYSTEM INSPECTION

PERMIT# 125370 PIN# 4706-75-0271 DATE 12-21-04

OWNER OR CONTRACTOR Heritage Building Company PHONE: Business (704) 902-4680 Home (704) 528-6644

ADDRESS 120 Hickory Ft Court Statesville, N.C. 28677

LOCATION Hwy 90 west, (R) Scotts Creek Rd, 2nd lot on Right past Larkin Lane

SUBDIVISION Scotts Creek BLOCK / SECTION — LOT 16 LOT AREA 1.004 Ac SITE CLASS PS DESIGN FLOW 360 L.T.A.R. .30

Septic Tank: 4,000 Gallons; STB 1012 Date 9-28-04
Pump Tank: ____ Gallons; PT ____ Date ____
Pump Make: ____ Model ____ Serial No. 800
Nitrification Field: No Fields 1 Square Feet 1200 Linear Feet ~~400~~ 470
No Lines ~~4~~ 4/100' Trench Width 36" Max Trench Bottom Depth 30" Gravel Depth 12"

☒ New System ☐ Repair System Type: I, ~~II~~, III, ~~IV~~, ~~V~~, ~~Other~~ RED
System Description: ~~Gravity, Conventional~~
Repair System Description: Gravity, 25% Reduction
Maintenance Agreement Required: ☐ Yes ☒ No


☒ House/Mod. Home No. Bedrooms 3
☐ Mobile Home No. Bathrooms ____
☐ Business No. Employees ____
☐ Other ____
☐ Slab ☒ Crawl Space ☐ Basement w/plumbing ☐ Basement wo/plumbing

Water Supply:
☐ Individual
☒ Public
☐ Community

Comments/Conditions:

Comments:/Conditions: SEPTIC TANK WITH MARKER INSTALLED USING "TUFTITE" FILTER

INITIAL SITE SKETCH

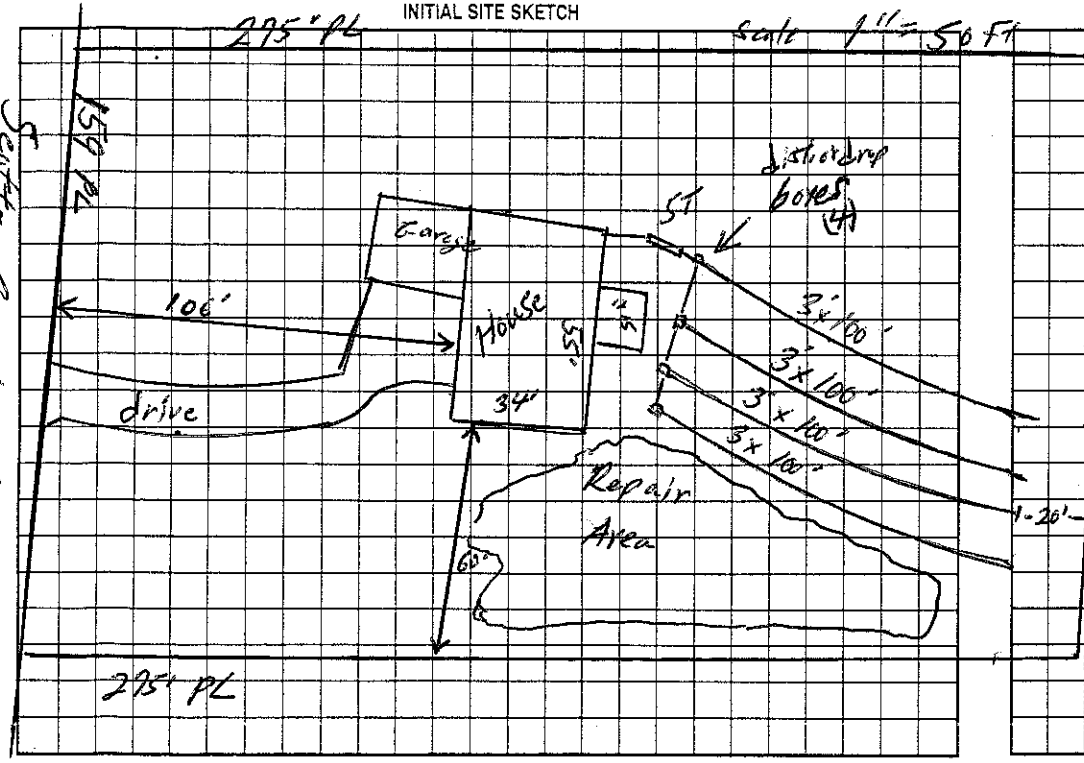

AS BUILT SKETCH

SYSTEM INSTALLED USING 75 'QUICK-4 INFILTRATOR' CHAMBERS AS ACCEPTED SYSTEM IN 3 x 3' x 100' LINES

Permit can be suspended or revoked if any false information is supplied toward securing the permit/any unauthorized changes are made to the site/any unauthorized changes are made in the installation of the system. Improvement Permit with plat valid without expiration. Improvement Permit with site plan valid for sixty months. Authorization to Construct is valid for a period equal to that of Improvement Permit – not to exceed sixty months.

Signed: [signature] date 12-21-04 Installed by: TOMMY FRYE

Improvement Permit by: William O. Johnson date 12/21/04 Operation Permit by: STEVE HENDRICK date 5-13-05

Authorization to Construct by: William O. Johnson date 12/21/04 Existing System Inspection by: ____ date ____

HEALTH DEPT. COPY: WHITE OWNER COPY (FINAL): YELLOW OWNER COPY (INITIAL): PINK