IREDELL COUNTY HEALTH DEPARTMENT

Statesville Phone TR 3-7271 Mooresville Phone NO 3-1271

PERMIT TO INSTALL SEPTIC TANK

Permit No. 290 Permit Date April 30 1971

Owner Juanita Johnson Address Scotts

Installed By Lackey Bros. Address Stony Point, NC


Location of Property Highway 90 west to near Scotts - Turn right on Road 1551 Cross RR tracks - Turn left on Road 1563 pass New Amity Church. Turn Right - 2nd trailer on left.

Tank		Capacity		Length of Lines		Fixtures	
Block	( )	1000	(✓)	225'	(✓)	No. of Baths	(1)
Precast	(✓)	1250	( )	250'	( )	Dishwasher	( )
		1500	( )	Other		Garbage Grdr.	( )
		Other				Other	

NOTIFY HEALTH DEPARTMENT AT LEAST EIGHT HOURS BEFORE TANK IS TO BE INSPECTED.

Final Inspection April 30 1971 Approved (✓) Disapproved ( )

Remarks No well at time of inst.

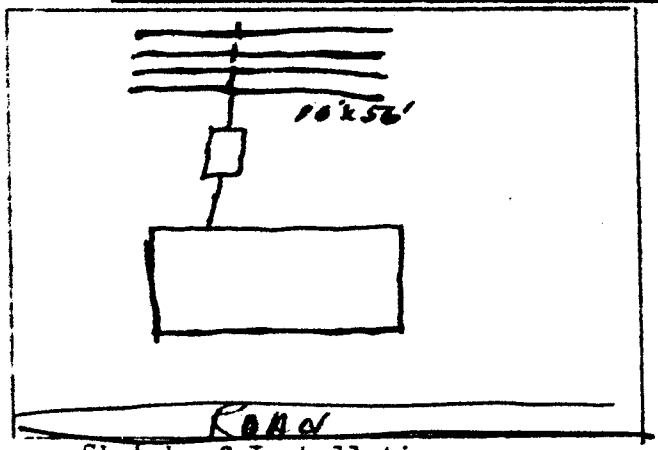

Sketch of Installation

Glenn Lackey

Sanitarian