IREDELL COUNTY HEALTH DEPARTMENT

STATESVILLE 704-878-5305 CI MOORESVILLE 704-664-5281

IMPROVEMENT PERMIT / AUTHORIZATION TO CONSTRUCT / OPERATION PERMIT / EXISTING SYSTEM INSPECTION

PERMIT# 12642 PIN# 4706843483 DATE 4-25-05

OWNER OR CONTRACTOR SAMUEL SCOTT CONTRACTING CO PHONE: Business 704-902-3230 Home

ADDRESS 2278 S CHIPLEY FORD RD STATESVILLE NC 28625

LOCATION 115 N ① SCOTTS CREEK ② DELLA ③ JIM LOT # 9 ON RT

SUBDIVISION LARKIN SLOAN BLOCK / SECTION LOT 9 LOT AREA 1.004 AC SITE CLASS. PS DESIGN FLOW 360 L.T.A.R. 1.5

Septic Tank: 1000 Gallons; STB 1012 Date 1-25-05
Pump Tank: Gallons; PT Date
Pump Make: Model Serial No.
Nitrification Field: No Fields 1 Square Feet 1200' Linear Feet 400'
No Lines 4 Trench Width 36" Max Trench Bottom Depth 36" Gravel Depth 12"

☒ New System ☐ Repair System Type: I, II, III, IV, V, VI
System Description: 60HY 62AV
Repair System Description: Pump 25% REDUCT
Maintenance Agreement Required: ☐ Yes ☒ No


☒ House/Mod. Home No. Bedrooms 3
☐ Mobile Home No. Bathrooms 2½
☐ Business No. Employees
☐ Other
☐ Slab ☒ Crawl Space ☐ Basement w/plumbing ☐ Basement wo/plumbing

Water Supply: ☐ Individual ☒ Public ☐ Community


Comments:/Conditions: ① INSTALL LINES ON CONTOURS ② MAINTAIN SETBACKS ③ HOUSE IS STAKED & DO NOT CUT FOR POSITIVE DRAINAGE

Comments:/Conditions: ④ NOTE TRENCH BOTTOM DEPTH. INSTALL LINES AT 36" DEEP

INITIAL SITE SKETCH "NOT TO SCALE"

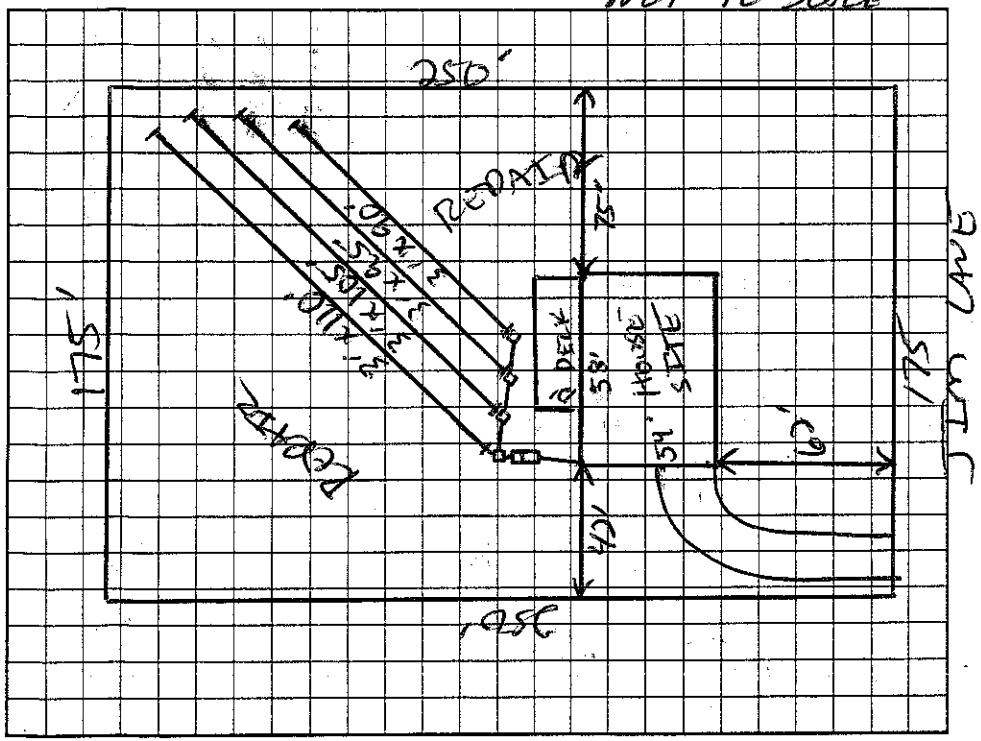

AS BUILT SKETCH

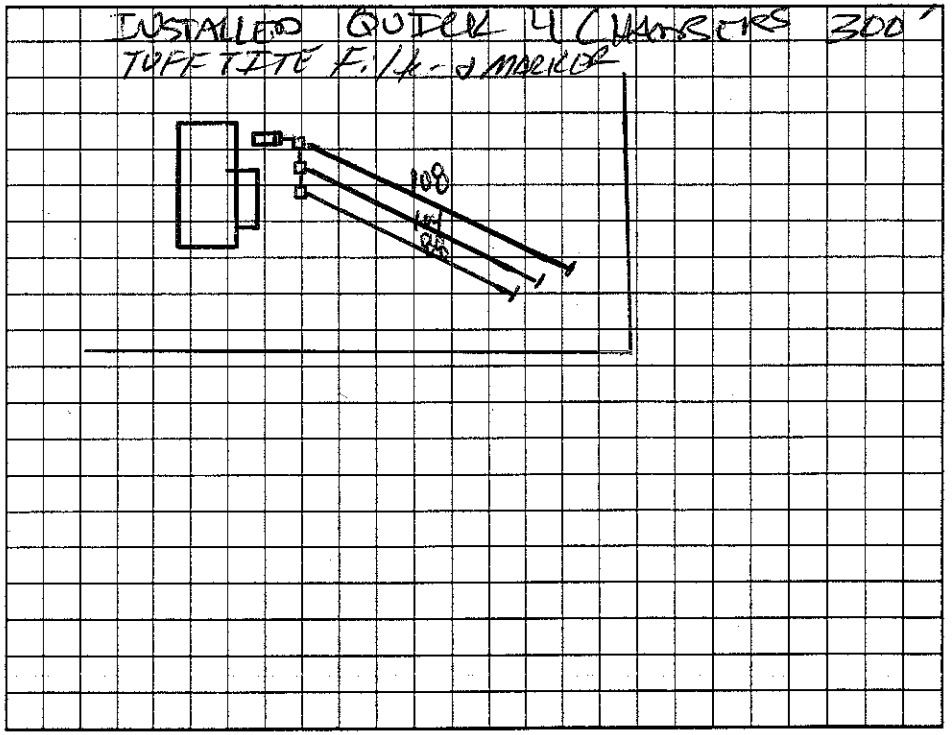

Permit can be suspended or revoked if any false information is supplied toward securing the permit/any unauthorized changes are made to the site/any unauthorized changes are made in the installation of the system. Improvement Permit with plat valid without expiration. Improvement Permit with site plan valid for sixty months. Authorization to Construct is valid for a period equal to that of Improvement Permit – not to exceed sixty months.

Signed: date

Improvement Permit by: date 4-25-05

Authorization to Construct by: date 4-25-05

Installed by: YOUNTZ & PADGETT

Operation Permit by: date 8-24-05

Existing System Inspection by: date

HEALTH DEPT. COPY: WHITE OWNER COPY (FINAL): YELLOW OWNER COPY (INITIAL): PINK