C1 Replaces Permit issued [redacted]. 06 Nov. 06

IREDELL COUNTY HEALTH DEPARTMENT

STATESVILLE 704-878-5305 MOORESVILLE 704-664-5281

IMPROVEMENT PERMIT / AUTHORIZATION TO CONSTRUCT / OPERATION PERMIT / EXISTING SYSTEM INSPECTION

PERMIT# 137570 PIN# 4706-86-~~0232.020~~ 3884 DATE 23 May 07

OWNER OR APPLICANT PEI Bldrs / Apex Developers PHONE: Business 704-902-1232 Home

ADDRESS 128 Suzuki Dr. Troutman, N.C. 28166

LOCATION Scotts Creek Rd. Turn into Forest Creek Go to END - on RT.

SUBDIVISION Forest Creek BLOCK / SECTION 2 LOT 20 LOT AREA 0.469 ac. SITE CLASS. PS DESIGN FLOW 360 gd L.T.A.R. 0.3/472/d

Septic Tank: 1000 Gallons; STB Date

Pump Tank: Gallons; PT Date

Pump Make: Model Serial No.

Nitrification Field: No Fields 1 Square Feet = 1200 Linear Feet 300'

No Lines 5 Trench Width 36" Max Trench Bottom Depth 36" Gravel Depth ☑ Gravity ☐ Pressure

☑ New System ☐ Repair ☐ Expansion System Type: I II III IV V VI

System Description: 25% Reduction

Repair System Description: 50% Reduction Pump

Maintenance Agreement Required: ☐ Yes ☐ No

☑ House/Mod. Home ☐ Mobile Home ☐ Business ☑ Other

No. Bedrooms 3 No. Persons No. Employees


Water Supply: ☐ Individual ☑ Public ☐ Community

☐ Slab ☑ Crawl Space ☐ Basement w/plumbing ☐ Basement wo/plumbing


Comments:/Conditions: Follow contours

Comments:/Conditions:

INITIAL SITE SKETCH

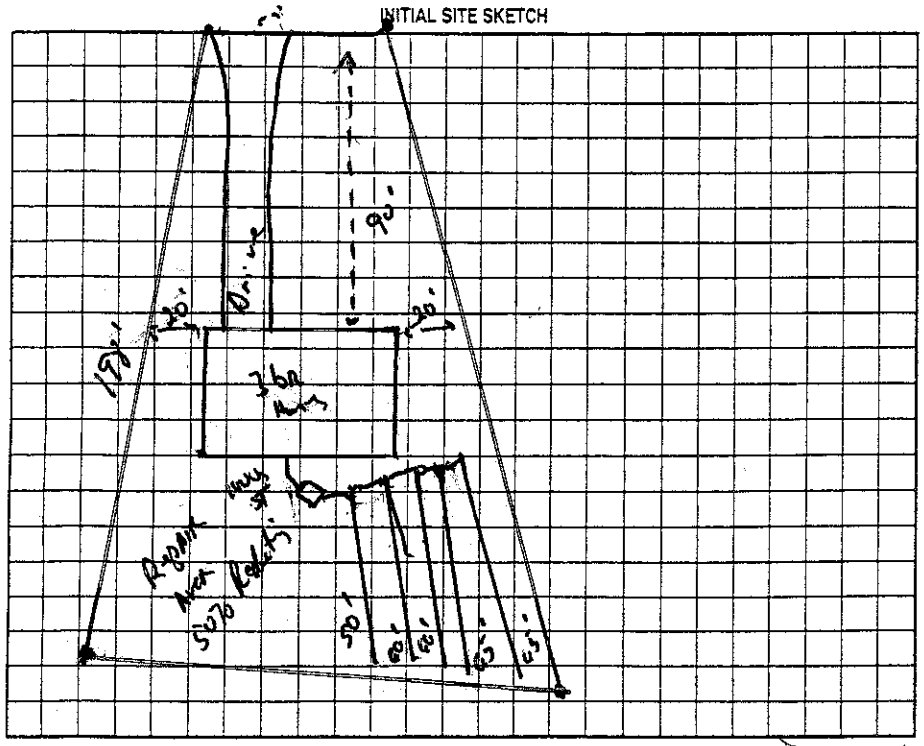

AS BUILT SKETCH

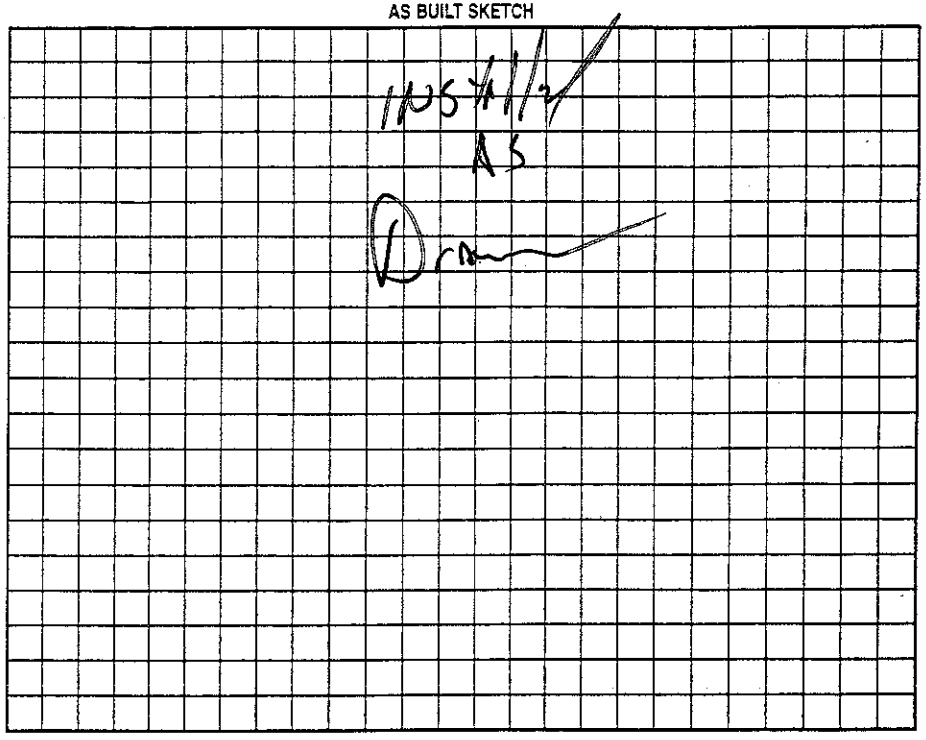

Permit can be suspended or revoked if any false information is supplied toward securing the permit/any unauthorized changes are made to the site/any unauthorized changes are made in the installation of the system. Improvement Permit with plat valid without expiration ☐ Improvement Permit with site plan valid for sixty months ☑ Authorization to Construct is valid for a period equal to that of Improvement Permit – not to exceed sixty months.

Signed: date 5-23-07 Installed by: Shankle Backhoe

Improvement Permit by: R.S. R.S. date 5-23-07 Operation Permit by: R.S. date 29 May 07

Authorization to Construct by: date 5-23-07 Existing System Inspection by: date

HEALTH DEPT. COPY: WHITE OWNER COPY (FINAL): YELLOW OWNER COPY (INITIAL): PINK