IREDELL COUNTY HEALTH DEPARTMENT

STATESVILLE 704-878-5305 MOORESVILLE 704-664-5281

IMPROVEMENT PERMIT / AUTHORIZATION TO CONSTRUCT / OPERATION PERMIT / EXISTING SYSTEM INSPECTION

PERMIT# 080723 PIN# 4706 99 0465 DATE 5-10-99

OWNER OR CONTRACTOR R. W. NICHOLSON PHONE: Business 876-4359 Home

ADDRESS 182 MILLSTONE DRIVE, STATESVILLE, NC 28625

LOCATION NC 115 N, TL SCOTTS CREEK, TL DELA, TL, JIM LANE, 2ND LOT on Right

SUBDIVISION LARKIN SLOAN BLOCK / SECTION LOT 8 LOT AREA 1.00 Acre SITE CLASS PS DESIGN FLOW 360 L.T.A.R. 0.30 GPD/A

Septic Tank: 1000.0 Gallons; STB 1011 TP Date 1-28-2000
Pump Tank: Gallons: P1 Date
Pump Make: Model Serial No.
Nitrification Field: No. Fields 1 Square Feet 1440 Linear Feet 480
No. Lines FOUR Trench Width 36" Max Trench Bottom Depth 36" Gravel Depth 12"

[X] New System [ ] Repair System Type: [I] II III IV V VI
System Description: CONVENTIONAL GRAVITY
Repair System Description: CONV. PUMP
Maintenance Agreement Required: [ ] Yes [X] No

[X] House/Mod. Home No. Bedrooms 3
[ ] Mobile Home No. Bathrooms 2
[ ] Business No. Employees
[ ] Other

[ ] Slab [X] Crawl Space [ ] Basement w/plumbing [ ] Basement w/o plumbing


Water Supply: [ ] Individual [X] Public [ ] Community

Comments/Conditions:

SCALE: 1" = 50'

Comments/Conditions

INITIAL SITE SKETCH

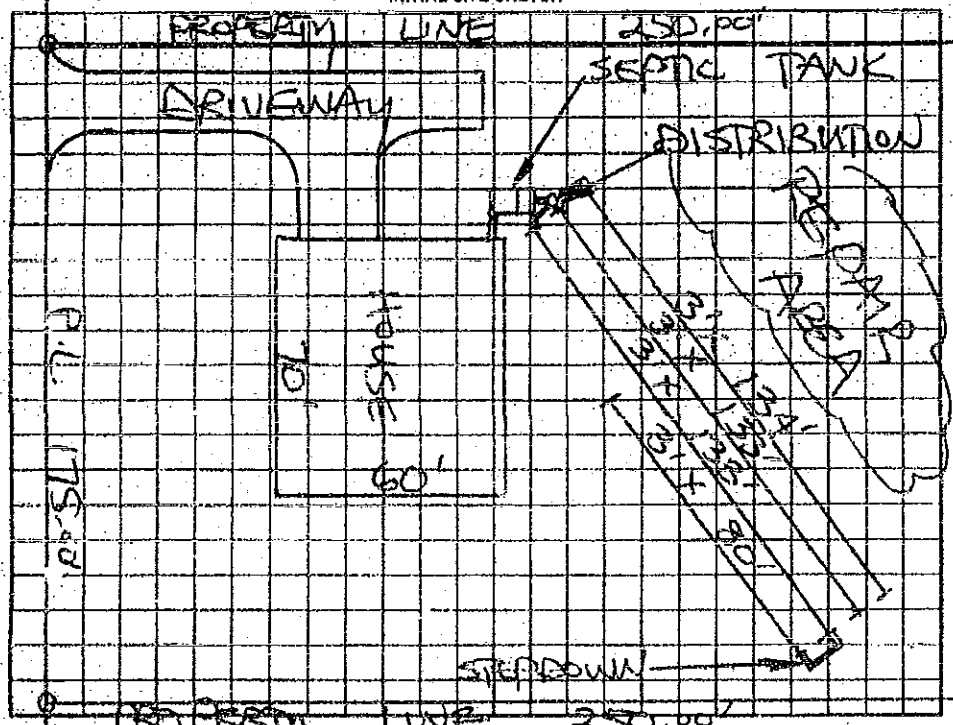

AS BUILT SKETCH

Permit can be suspended or revoked if any false information is supplied toward securing the permit/any unauthorized changes are made to the site/any unauthorized changes are made in the installation of the system. Improvement Permit with plat valid without expiration. Improvement Permit with site plan valid for sixty months. Authorization to Construct is valid for a period equal to that of Improvement Permit – not to exceed sixty months.

Signed: [signature] date

Installed by: DAVID HUNTER

Improvement Permit by: STEVE HEDRICK date 5-10-99

Operation Permit by: [signature], RS date 6-2-00

Authorization to Construct by: STEVE HEDRICK date 5-10-99

Existing System Inspection by: date

HEALTH DEPT. COPY WHITE OWNER COPY (FINAL) YELLOW OWNER COPY (INITIAL) PINK