IREDELL COUNTY HEALTH DEPARTMENT

STATESVILLE 704-878-5305 MOORESVILLE 704-664-5281

IMPROVEMENT PERMIT / CERTIFICATE OF COMPLETION / OPERATION PERMIT / EXISTING SYSTEM INSPECTION

PROPERTY DESCRIPTION NO. 18242 DATE 4/11/94 TAX MAP NO. 9E-A-12 (28) Watershed: ☐ Yes ☒ No

OWNER OR CONTRACTOR BRYAN LEAIRD PHONE: Business Home 528-3581

ADDRESS 106 DAWNWOOD LANE, STATESVILLE, NC 28677

LOCATION NC 115 N TL SCOTTS CREEK RD, TL ROBERT DR, TR MOBEAL LANE LOT ON (2)

SUBDIVISION LARKIN SLOAN BLOCK / SECTION LOT 28 LOT AREA 1.04 AC SITE CLASS PS DESIGN FLOW 360 L.T.A.R. 0.35 GPD/FT²

Septic Tank: 1000 Gallons; STB 1012 Date 7/14/94

Pump Tank: Gallons; PT Date

Pump Make: Model Serial No.

Nitrification Field: No Fields 1 Square Feet 1035 Linear Feet 345

No Lines 5 Trench Width 36" Max Trench Bottom Depth 18-36" Gravel Depth 12"

☒ New System ☐ Repair System Type: I (II) III, IV, V, VI

System Description: CONV. GRAVITY

Repair System Description: CONV. GRAVITY

Maintenance Agreement Required: ☐ Yes ☒ No

☒ House/Mod. Home No. Bedrooms 3

☐ Mobile Home No. Bathrooms 2

☐ Business No. Employees


☐ Other

☐ Slab ☐ Crawl Space ☐ Basement w/plumbing ☐ Basement wo/plumbing

Water Supply: ☐ Individual ☐ Community ☒ Public


Comments: (1) KEEP SYSTEM MINIMUM 5' FROM HOUSE 10' FROM PROPERTY LINE, 10' FROM WATER LINE (2) INSTALL LINES ON CONTOUR NO DEEPER THAN 36", 9' APART ON CENTERS

INITIAL SITE SKETCH

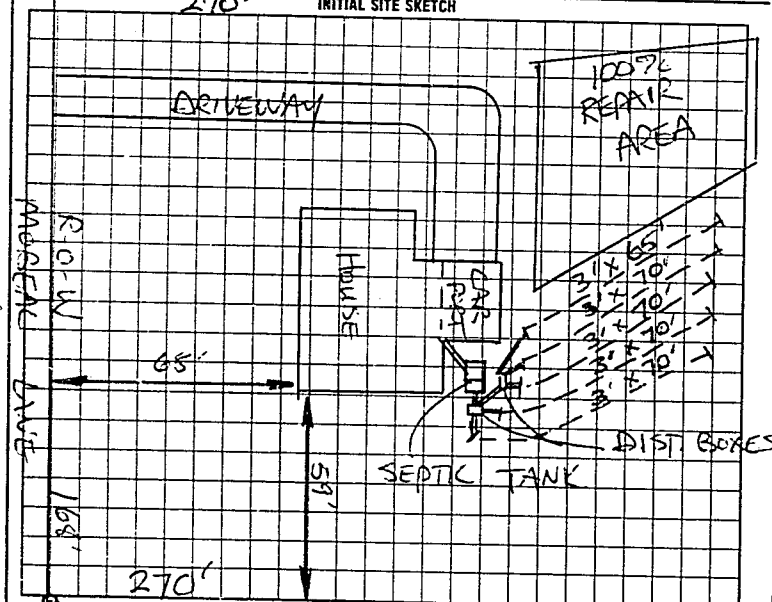

Comments:

AS BUILT SKETCH

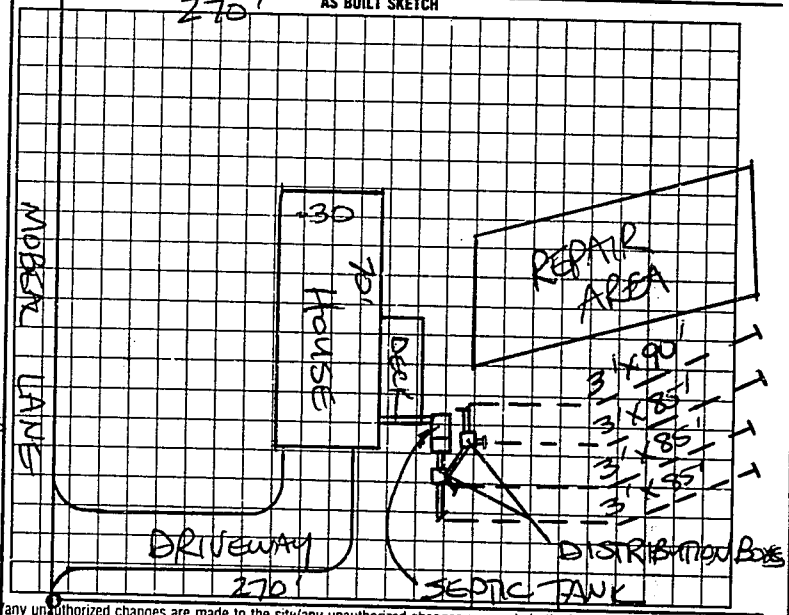

I understand that this permit can be suspended or revoked if any false information is supplied toward securing the permit any unauthorized changes are made to the site/any unauthorized changes are made in the installation of the system. Improvement Permit is valid for 60 months from date of issuance.

Signed: X Bryan Leaird

Improvement Permit by: STEVE HENDRICK date 4/11/94

Existing System Inspection by: date

Installed by: DAVID YOUNTZ

Certificate of Completion by: STEVE HENDRICK date 9/30/94

Operation Permit by: date

HEALTH DEPT. COPY WHITE INSPECTION COPY (FINAL) GREEN OWNER COPY (FINAL) YELLOW INSPECTION COPY (INITIAL) PINK OWNER COPY (INITIAL) GOLD