330

IREDELL COUNTY HEALTH DEPARTMENT

STATESVILLE 704-878-5305 MOORESVILLE 704-664-5281

IMPROVEMENT PERMIT / CERTIFICATE OF COMPLETION / OPERATION PERMIT / EXISTING SYSTEM INSPECTION

PROPERTY DESCRIPTION NO. 25081 DATE 9-25-96 TAX MAP NO. 9F-3-A-32 (PART) Watershed: ☐ Yes ☑ No

OWNER OR CONTRACTOR SAMUEL SCOTT PHONE: Business Home 873-1391

ADDRESS 2278 S. CHIPLEY FORD ROAD, STATESVILLE, NC 28677

LOCATION NC 115 N, TL SCOTT CREEK RD TL DELA DRIVE 2ND LOT ON LEFT

SUBDIVISION LARKIN SLOAN BLOCK / SECTION LOT 32(PT) LOT AREA ~199 X 199' SITE CLASS PS DESIGN FLOW 360 L.T.A.R. 0.30 GPD/FT²

Septic Tank: 1000 Gallons; STB 1012 Date 11-31-96

Pump Tank: Gallons; PT Date

Pump Make: Model Serial No.

Nitrification Field: No Fields 1 Square Feet 1200 Linear Feet 400

No Lines FOUR Trench Width 36" Max Trench Bottom Depth 36" Gravel Depth 12"

☑ New System ☐ Repair System Type: I, II, III, IV, V, VI

System Description: CONVENTIONAL GRAVITY

Repair System Description: CONV. GRAVITY

Maintenance Agreement Required: ☐ Yes ☑ No

☑ House/Mod. Home No. Bedrooms 3

☐ Mobile Home No. Bathrooms 2

☐ Business No. Employees

☐ Other


☐ Slab ☑ Crawl Space ☐ Basement w/plumbing ☐ Basement wo/plumbing

Water Supply: ☐ Individual ☐ Community ☑ Public


Comments:

Comments:

INITIAL SITE SKETCH

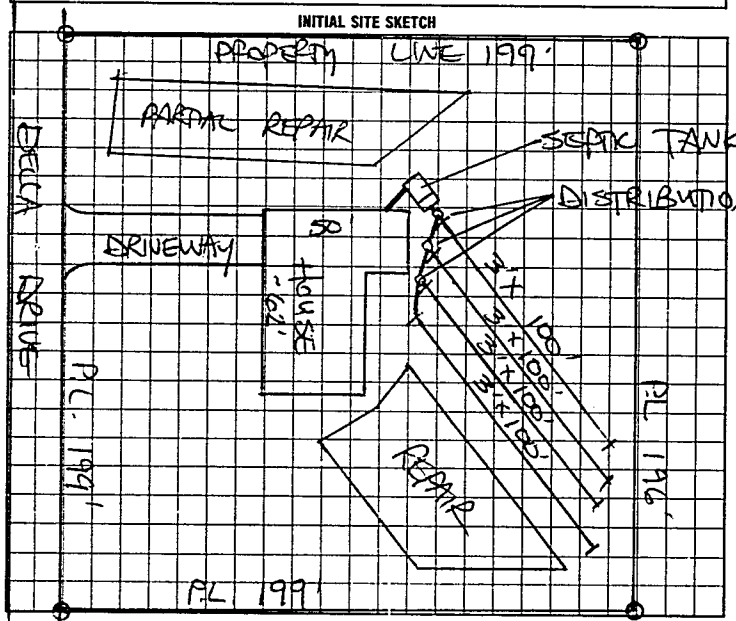

AS BUILT SKETCH

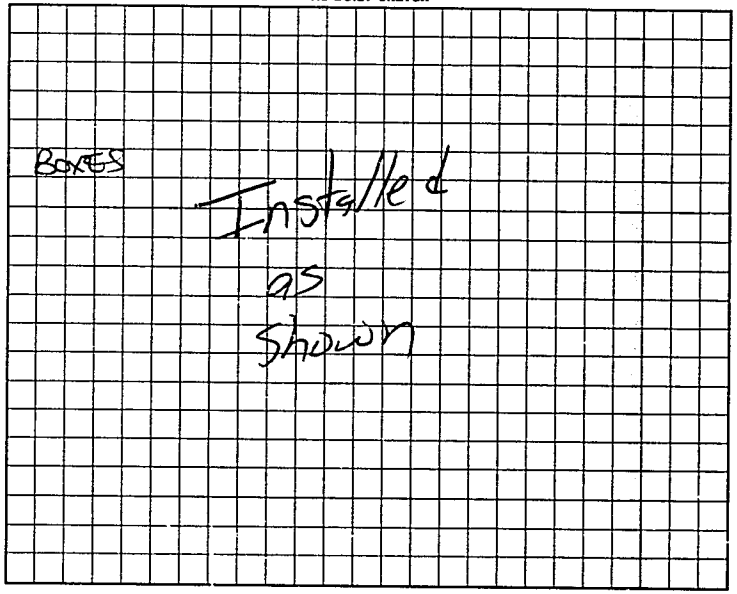

I understand that this permit can be suspended or revoked if any false information is supplied toward securing the permit/any unauthorized changes are made to the site/any unauthorized changes are made in the installation of the system.

AUTH. TO CONST. IS VALID FOR A PERIOD EQUAL TO THE VALIDITY OF THE I.P NOT TO EXCEED FIVE YEARS. I.P W/SITE PLAN IS VALID FIVE YEARS

Signed:

Improvement Permit by: STEVE HEDRICK date 9-25-96

AUTHORIZATION TO CONSTRUCT

Existing System Inspection by: STEVE HEDRICK date 9-25-96

Installed by: David Yount

Certificate of Completion by: date

Operation Permit by: Mark Cox PS date 3-13-97

HEALTH DEPT. COPY: WHITE INSPECTION COPY (FINAL): GREEN OWNER COPY (FINAL): YELLOW INSPECTION COPY (INITIAL): PINK OWNER COPY (INITIAL): GOLD

9752006