IREDELL COUNTY HEALTH DEPARTMENT 4706954075

STATESVILLE 704-878-5305 MOORESVILLE 704-664-5281

IMPROVEMENT PERMIT / AUTHORIZATION TO CONSTRUCT / OPERATION PERMIT / EXISTING SYSTEM INSPECTION

PERMIT# 25081 PIN# ~~9-25-96~~ 7F-34-32 TAX MAP # DATE 9-25-96

OWNER OR CONTRACTOR Tony Daugherty PHONE: Business Home 704-873-1941

ADDRESS 113 Delta Drive Statesville NC

LOCATION 115 N. to Scotts Creek RD TL Delta RD 2ND Lot on Left

SUBDIVISION Lakin Stow BLOCK / SECTION LOT 32 LOT AREA .99 AC SITE CLASS. P5 DESIGN FLOW 360 L.T.A.R. .3

Septic Tank: 1000 Gallons; STB 1012 Date 11-31-96

Pump Tank: Gallons; PT Date

Pump Make: Model Serial No.

Nitrification Field: No Fields Square Feet 1200 Linear Feet 400

No Lines 4 Trench Width 36" Max Trench Bottom Depth 36" Gravel Depth 12

☐ New System ☐ Repair System Type: I, II, III, IV, V, VI

System Description: Conventional Gravity

Repair System Description: 2500 Pump

Maintenance Agreement Required: ☐ Yes ☒ No

☐ House/Mod. Home No. Bedrooms 3

☐ Mobile Home No. Bathrooms

☐ Business No. Employees

☐ Other

☐ Slab ☒ Crawl Space ☐ Basement w/plumbing ☐ Basement wo/plumbing


Water Supply: ☐ Individual ☒ Public ☐ Community

Comments:/Conditions:


Comments:/Conditions:

Customer had Repair reevaluated for additions onto house and pool.

INITIAL SITE SKETCH

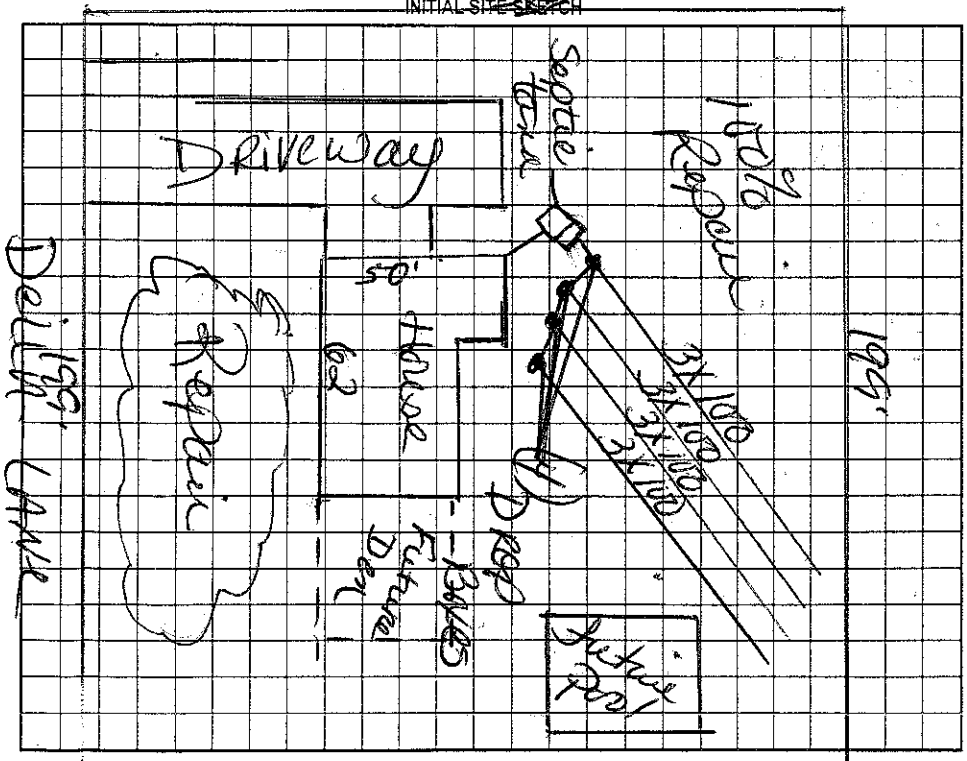

AS BUILT SKETCH

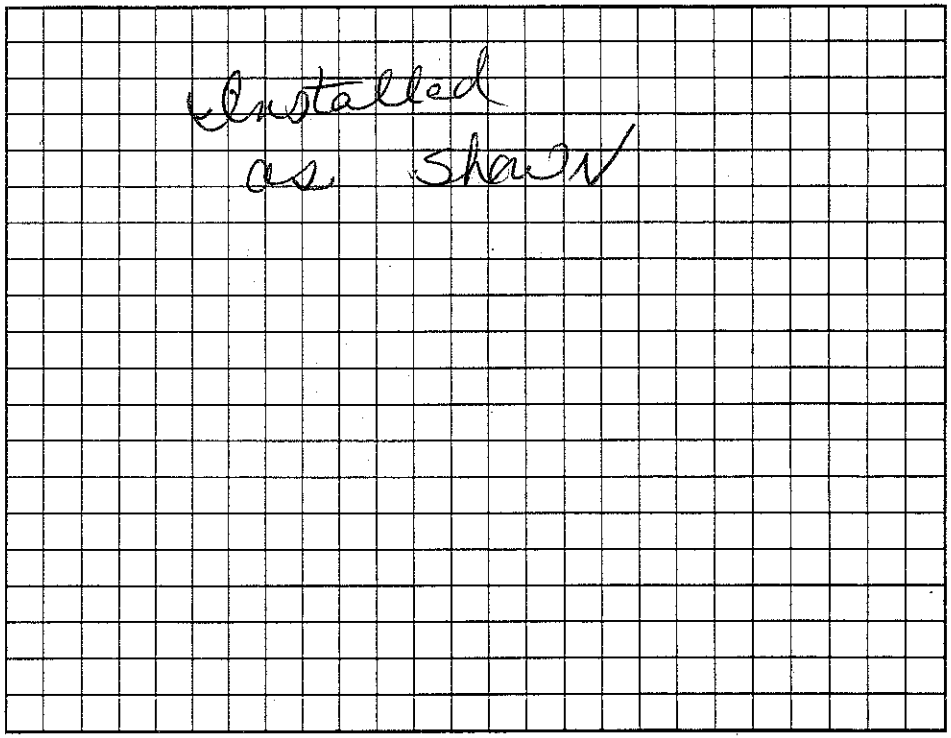

Permit can be suspended or revoked if any false information is supplied toward securing the permit/any unauthorized changes are made to the site/any unauthorized changes are made in the installation of the system. Improvement Permit with plat valid without expiration. Improvement Permit with site plan valid for sixty months. Authorization to Construct is valid for a period equal to that of Improvement Permit – not to exceed sixty months.

Signed: Andrew W. Daugherty date Installed by:

Improvement Permit by: Kelli Cook date 9-15-05 Operation Permit by: date

Authorization to Construct by: Kelli Cook date 9-15-05 Existing System Inspection by: Kelli L Cook date 9-15-05

HEALTH DEPT. COPY: WHITE OWNER COPY (FINAL): YELLOW OWNER COPY (INITIAL): PINK