Samuel Scott

IREDELL COUNTY HEALTH DEPARTMENT

STATESVILLE 704-878-5305 MOORESVILLE 704-664-5281

56000

IMPROVEMENT PERMIT / CERTIFICATE OF COMPLETION / OPERATION PERMIT / EXISTING SYSTEM INSPECTION

PROPERTY DESCRIPTION NO. 2157 DATE 5/18/95 TAX MAP NO. 9F-3-A-32 Watershed: ☐ Yes ☑ No

OWNER OR CONTRACTOR WALTER CHILDERS PHONE: Business 873-1397 Home SAMUEL SCOTT

ADDRESS 2310 S. CHIPLEY FORD STATESVILLE NC 28677

LOCATION NC 90 W, TR SCOTTS CREEK RD, LOT ON RIGHT AT DELLA LANE

SUBDIVISION LAKIN SLOAN BLOCK / SECTION ____ LOT 32 LOT AREA 1 ACRE SITE CLASS. PS DESIGN FLOW 360 L.T.A.R. 0.35

Septic Tank: 1000 Gallons; STB 1012 Date 4-23-95

Pump Tank: ____ Gallons; PT ____ Date ____

Pump Make: ____ Model ____ Serial No. ____

Nitrification Field: No Fields 1 Square Feet 1035 Linear Feet 345

No Lines 3 Trench Width 36" Max Trench Bottom Depth 18-36" Gravel Depth 12"

☑ New System ☐ Repair System Type: I, II, III, IV, V, VI

System Description: CONVENTIONAL GRAVITY

Repair System Description: CONV. GRAVITY

Maintenance Agreement Required: ☐ Yes ☑ No

☑ House/Mod. Home No. Bedrooms 3

☐ Mobile Home No. Bathrooms 3

☐ Business No. Employees ____


☐ Other ____

☐ Slab ☑ Crawl Space ☐ Basement w/plumbing ☐ Basement wo/plumbing

Water Supply: ☐ Individual ☐ Community ☑ Public

Comments:

INITIAL SITE SKETCH

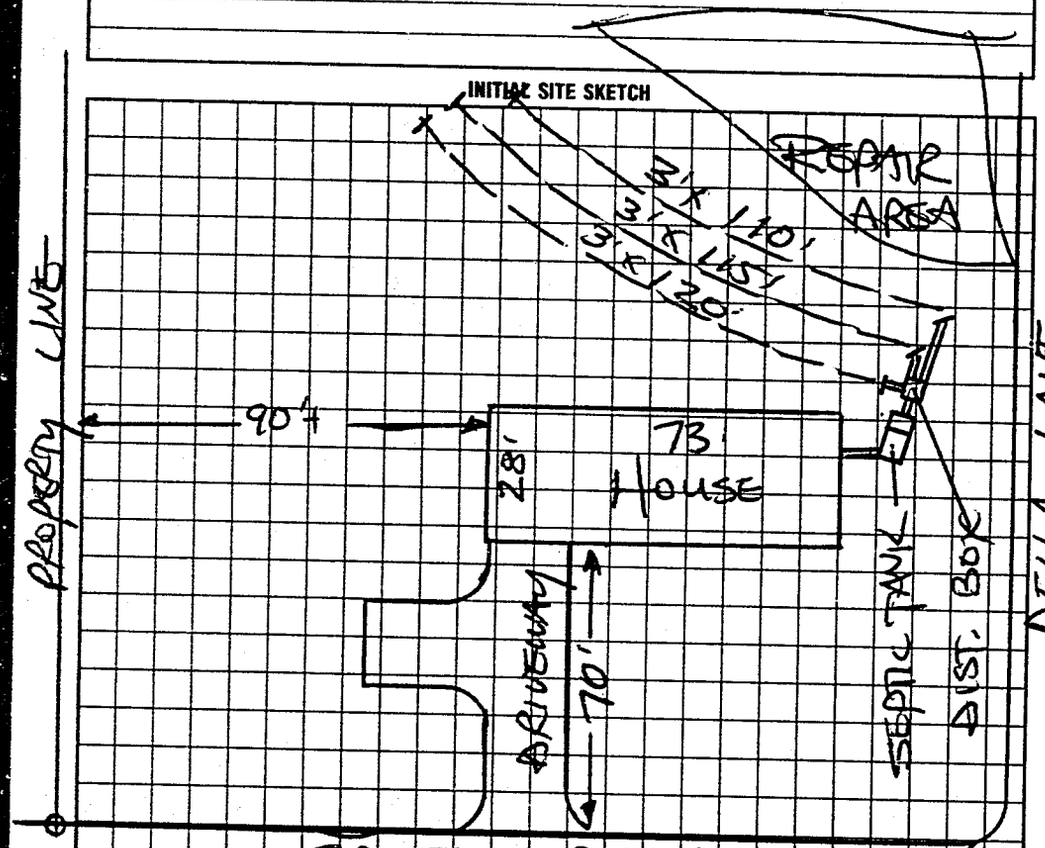

Comments:

AS BUILT SKETCH

SYSTEM INSTALLED ACCORDING TO INITIAL SITE SKETCH

I understand that this permit can be suspended or revoked if any false information is supplied toward securing the permit/any unauthorized changes are made to the site/any unauthorized changes are made in the installation of the system. Improvement Permit is valid for 60 months from date of issuance.

Signed: Samuel L Scott

Improvement Permit by: STEVE HEDRICK date 5/18/95

Existing System Inspection by: ____ date ____

Installed by: DAVID YOUNTZ

Certificate of Completion by: STEVE HEDRICK date 7-31-95

Operation Permit by: ____ date ____

HEALTH DEPT. COPY: WHITE INSPECTION COPY (FINAL): GREEN OWNER COPY (FINAL): YELLOW INSPECTION COPY (INITIAL): PINK OWNER COPY (INITIAL): GOLD